



## **APPENDIX A – REPAIR DEFECT MAP AND REGISTER**

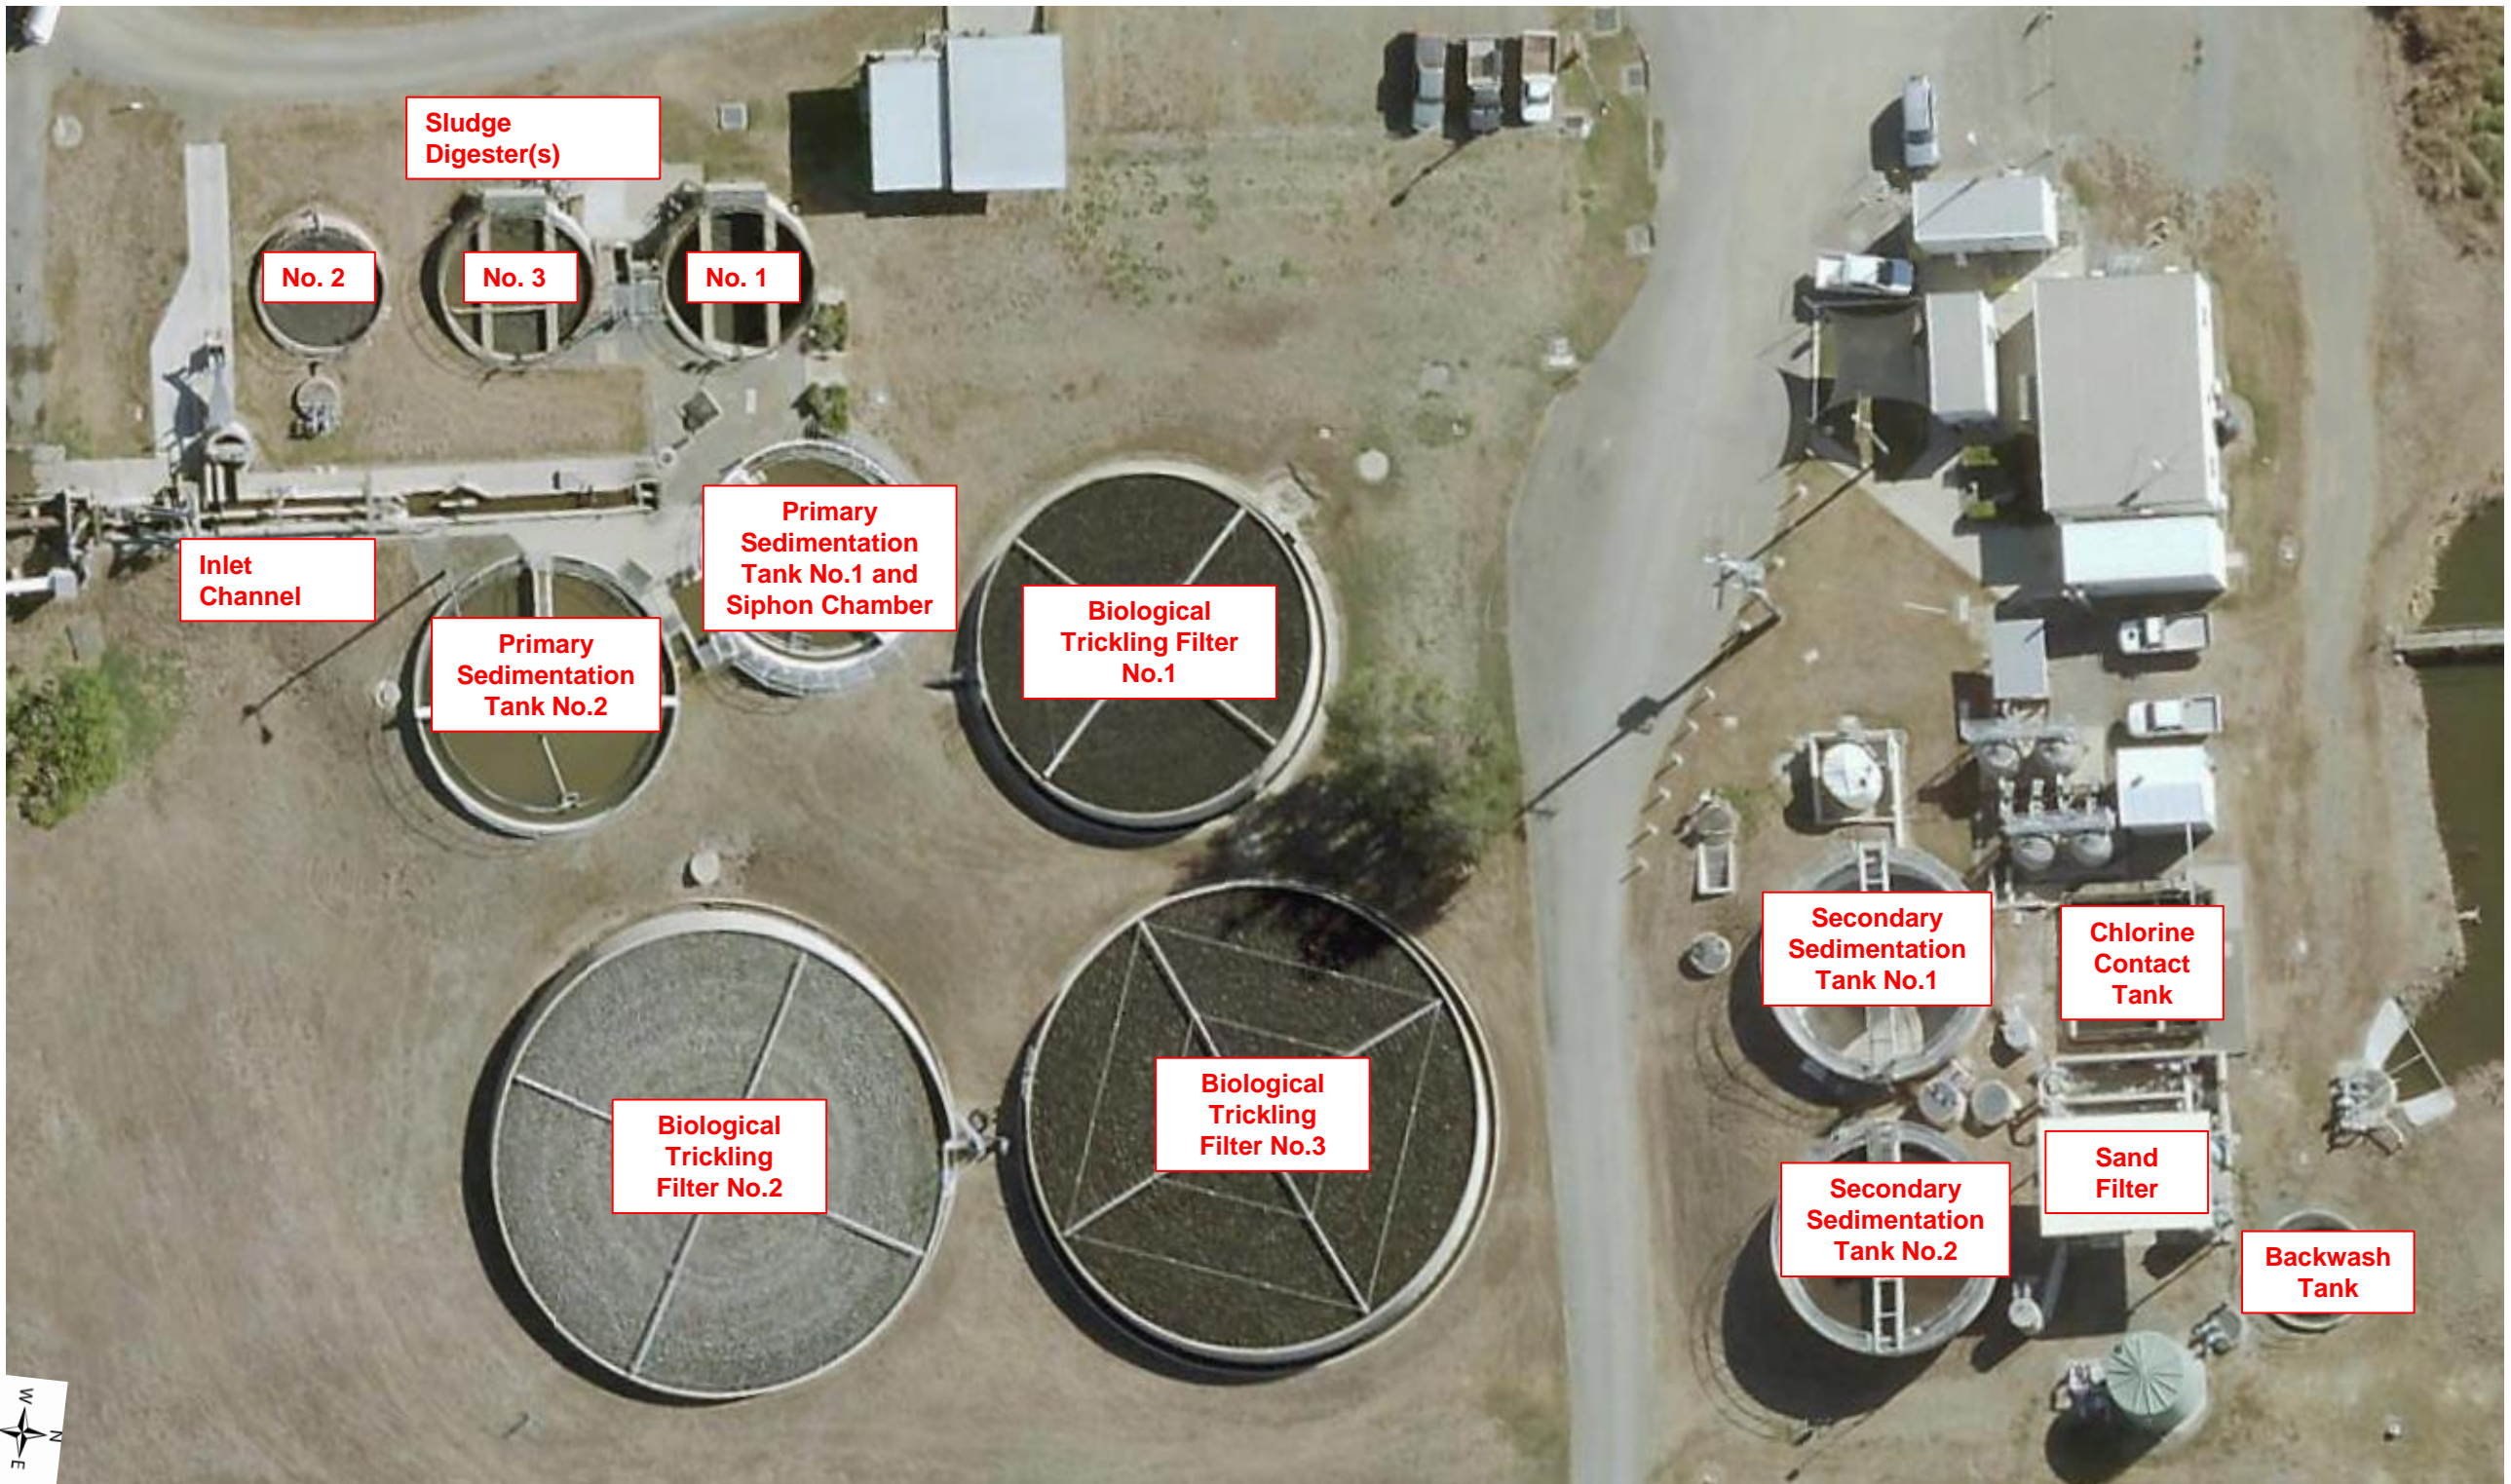

# BILOELA STP REPAIR PROJECT – PST 1 AND SIPHON CHAMBER

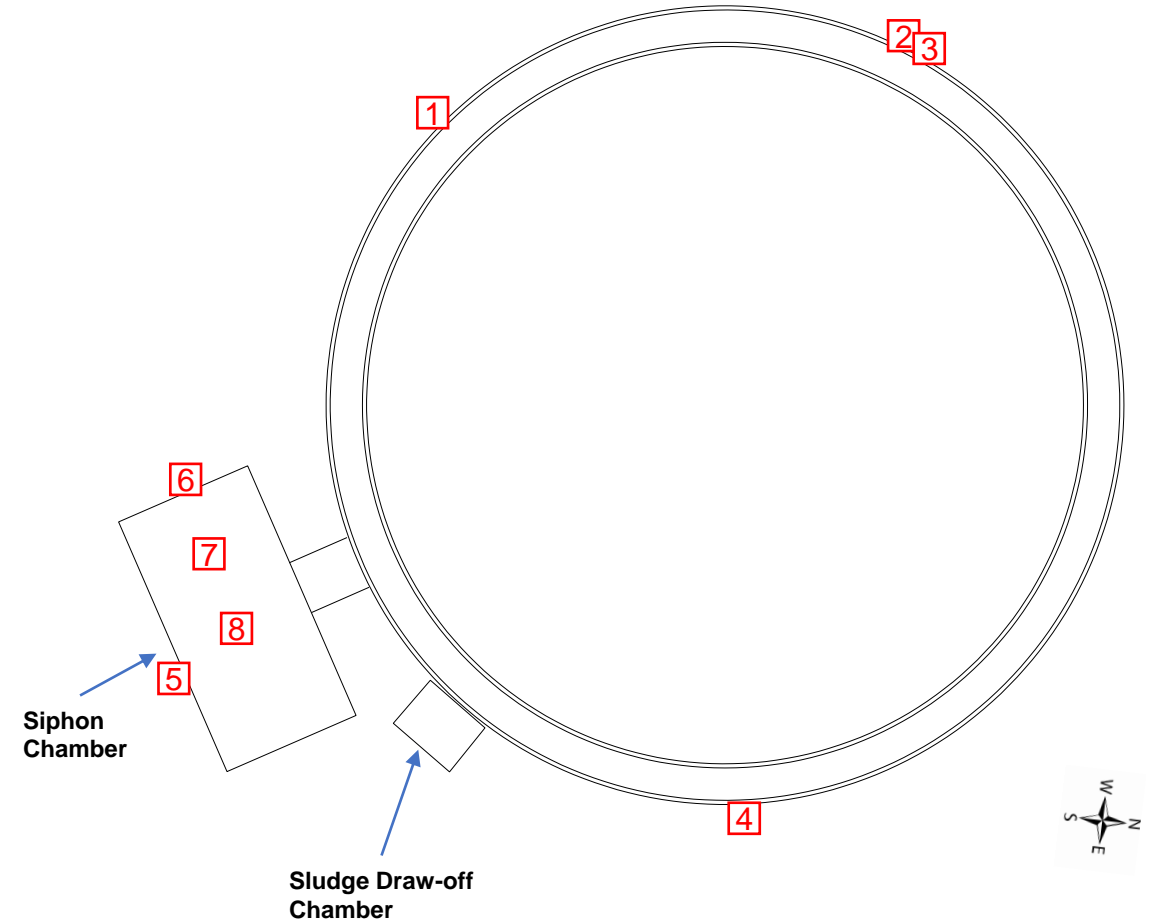

REPAIR NO.	ELEMENT	DEFECT	ACTION	REPAIR AREA LENGTH (mm)	REPAIR AREA WIDTH (mm)	DEPTH/MAX CRACK WIDTH (mm)	REPAIR AREA (m <sup>2</sup> )
1	Laundry channel wall - Top	Delamination and cracking	Concrete repair	2400	250	100	0.60
2	Laundry channel wall - External	Cracking	Crack injection	850	-	1.5	-
3	Laundry channel wall - External	Delamination and cracking	Concrete repair	350	200	-	0.07
4	Laundry channel wall and soffit - External	Delamination and cracking	Concrete repair	1400	140	-	0.20
5	Siphon chamber wall - External	Vertical cracking	Crack injection	350	-	0.5	-
6	Siphon chamber wall - Top	Cracking	Crack injection	750	-	0.8	-
7	Siphon chamber internal dividing wall - Internal surfaces above waterline	Delamination, cracking, and spalling	Concrete repair	500	500	-	0.25
8	Siphon chamber perimeter wall - Internal surfaces above waterline	Heavy etching and exposed aggregate	Apply epoxy protective coating to siphon chamber walls above waterline	10000	1000	-	10.00

# BILOELA STP REPAIR PROJECT – PST 1 AND SIPHON CHAMBER



PST 1 - Repair No. 1



PST 1 - Repair No. 2



PST 1 - Repair No. 3



PST 1 - Repair No. 4



PST 1 - Repair No. 5



PST 1 - Repair No. 6




PST 1 - Repair No. 7



PST 1 - Repair No. 8



# BILOELA STP REPAIR PROJECT – PST 2

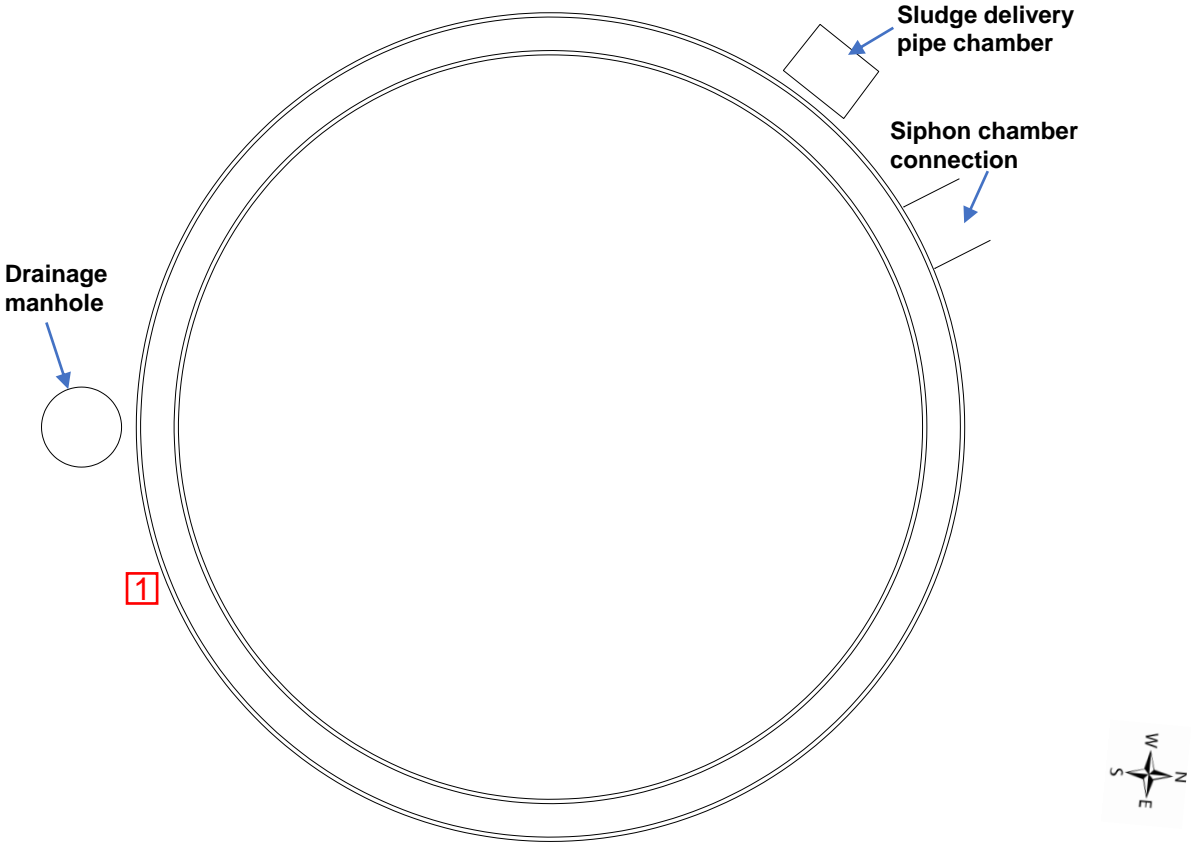


REPAIR NO.	ELEMENT	DEFECT	ACTION	REPAIR AREA LENGTH (mm)	REPAIR AREA WIDTH (mm)	DEPTH/MAX CRACK WIDTH (mm)	REPAIR AREA (m <sup>2</sup> )
1	Laundry channel wall - External	Delamination, cracking, and spalling	Concrete repair	400	150	100	0.06

# BILOELA STP REPAIR PROJECT – PST 2



PST 2 - Repair No. 1


# BILOELA STP REPAIR PROJECT – BTF 1

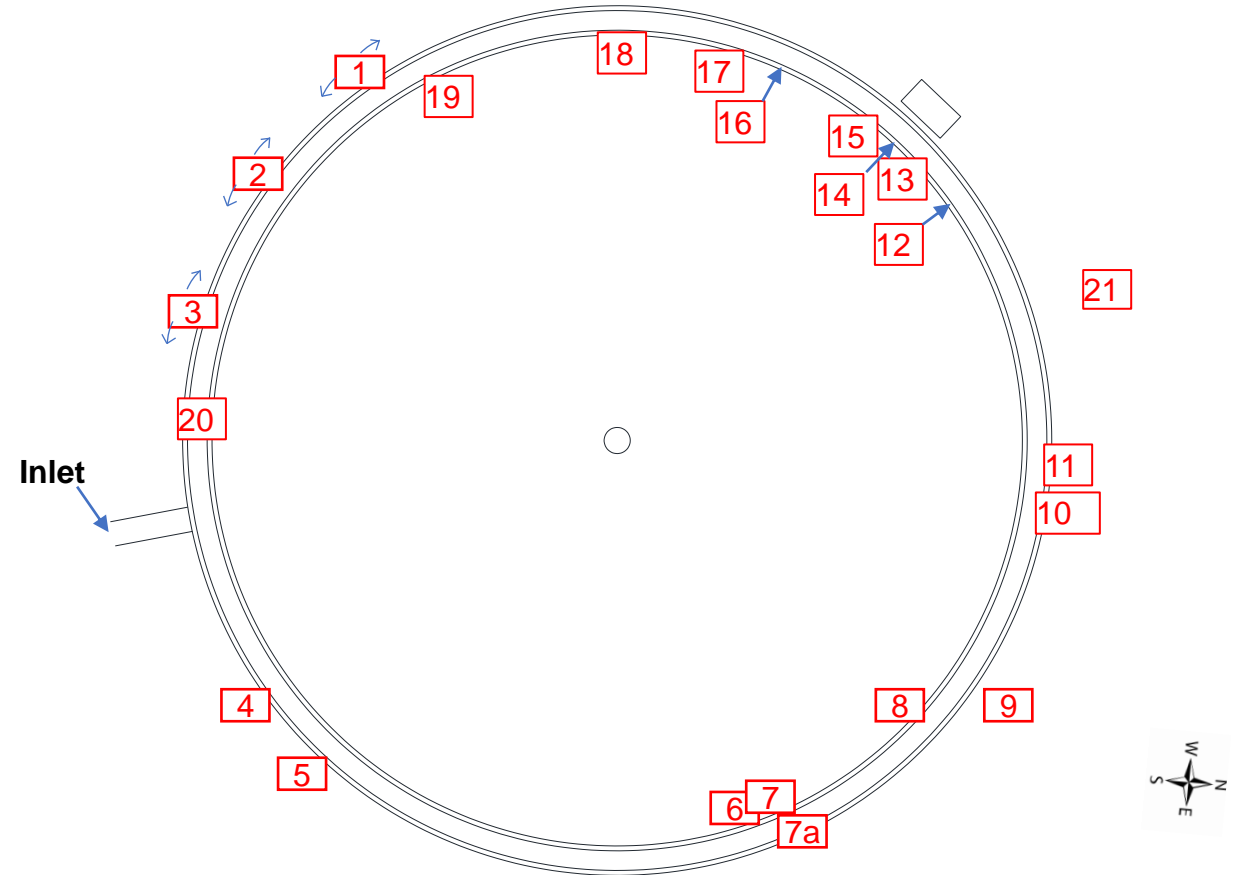

REPAIR NO.	ELEMENT	DEFECT	ACTION	REPAIR AREA LENGTH (mm)	REPAIR AREA WIDTH (mm)	DEPTH/MAX CRACK WIDTH (mm)	REPAIR AREA (m <sup>2</sup> )
1	Tank wall - External	Horizontal cracking	Crack injection	60000	-	0.2 - 5	-
2	Tank wall - External	Widespread cracking 0.2 - 0.6mm wide, all directions	Crack injection	11000	-	0.2-0.6	-
3	Tank wall - External	Minor spalls, no exposed reinforcement	Concrete repair	100	100	-	0.01
4	Tank wall - External	Delamination	Concrete repair	1000	300	-	0.30
5	Tank wall - External	Delamination	Concrete repair	1400	1150	-	1.61
6	Tank wall - External	Delamination	Concrete repair	700	850	-	0.60
7	Tank wall - External	Delamination	Concrete repair	500	500	-	0.25
7a	Tank wall - External	Delamination	Concrete repair	1100	125	-	0.14
8	Tank wall - External	Delamination and spalling	Concrete repair	1650	950	-	1.57
9	Tank wall - External	Delamination and spalling	Concrete repair	3100	1600	-	4.96

# BILOELA STP REPAIR PROJECT – BTF 1

REPAIR NO.	ELEMENT	DEFECT	ACTION	REPAIR AREA LENGTH (mm)	REPAIR AREA WIDTH (mm)	DEPTH/MAX CRACK WIDTH (mm)	REPAIR AREA (m <sup>2</sup> )
10	Tank wall - External	Delamination	Concrete repair	400	350	-	0.14
11	Tank wall - External	Delamination and spalling	Concrete repair	3800	950	-	3.61
12	Tank wall - External	Delamination and spalling	Concrete repair	1750	700	-	1.23
13	Tank wall - External	Delamination and spalling	Concrete repair	1300	400	-	0.52
14	Tank wall - External	Delamination	Concrete repair	750	350	-	0.26
15	Tank wall - External	Delamination and spalling	Concrete repair	1550	550	-	0.85
16	Tank wall - External	Delamination	Concrete repair	300	500	-	0.15
17	Tank wall - External	Delamination and spalling, exposed corroded reinforcement	Concrete repair	1800	700	-	1.26
18	Tank wall - External	Delamination	Concrete repair	400	350	-	0.14
19	Tank wall - External	Delamination	Concrete repair	2000	600	-	1.20
20	Tank wall - External	Delamination	Concrete repair	700	700	-	0.49
21	Tank wall - External	Carbonation to external surface	Apply anti-carbonation coating to full external surface of perimeter wall including top of perimeter wall	-	-	-	96.00



# BILOELA STP REPAIR PROJECT – BTF 1



BTF 1 - Repair No. 1



BTF 1 - Repair No. 2



BTF 1 - Repair No. 3



BTF 1 - Repair No. 4



BTF 1 - Repair No. 5



BTF 1 - Repair No. 6



BTF 1 - Repair No. 7



BTF 1 - Repair No. 7a



BTF 1 - Repair No. 8



BTF 1 - Repair No. 9



BTF 1 - Repair No. 10



BTF 1 - Repair No. 11


# BILOELA STP REPAIR PROJECT – BTF 1



BTF 1 - Repair No. 12



BTF 1 - Repair No. 13

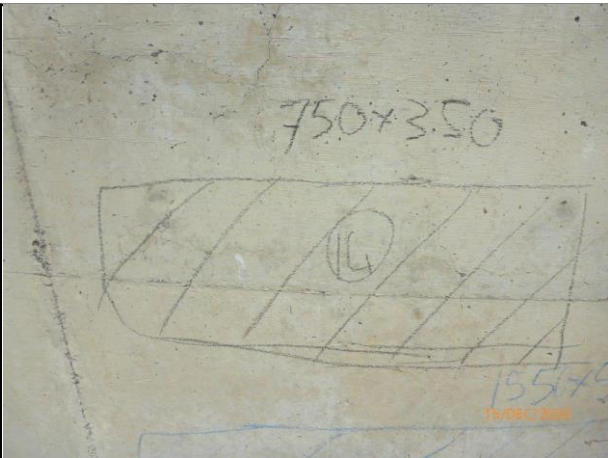

BTF 1 - Repair No. 14




BTF 1 - Repair No. 15



BTF 1 - Repair No. 16



BTF 1 - Repair No. 17

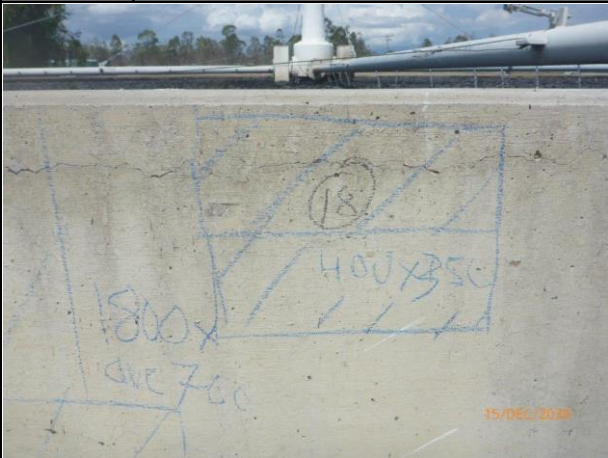

BTF 1 - Repair No. 18



BTF 1 - Repair No. 19




BTF 1 - Repair No. 20



BTF 1 - Repair No. 21



# BILOELA STP REPAIR PROJECT – BTF 3

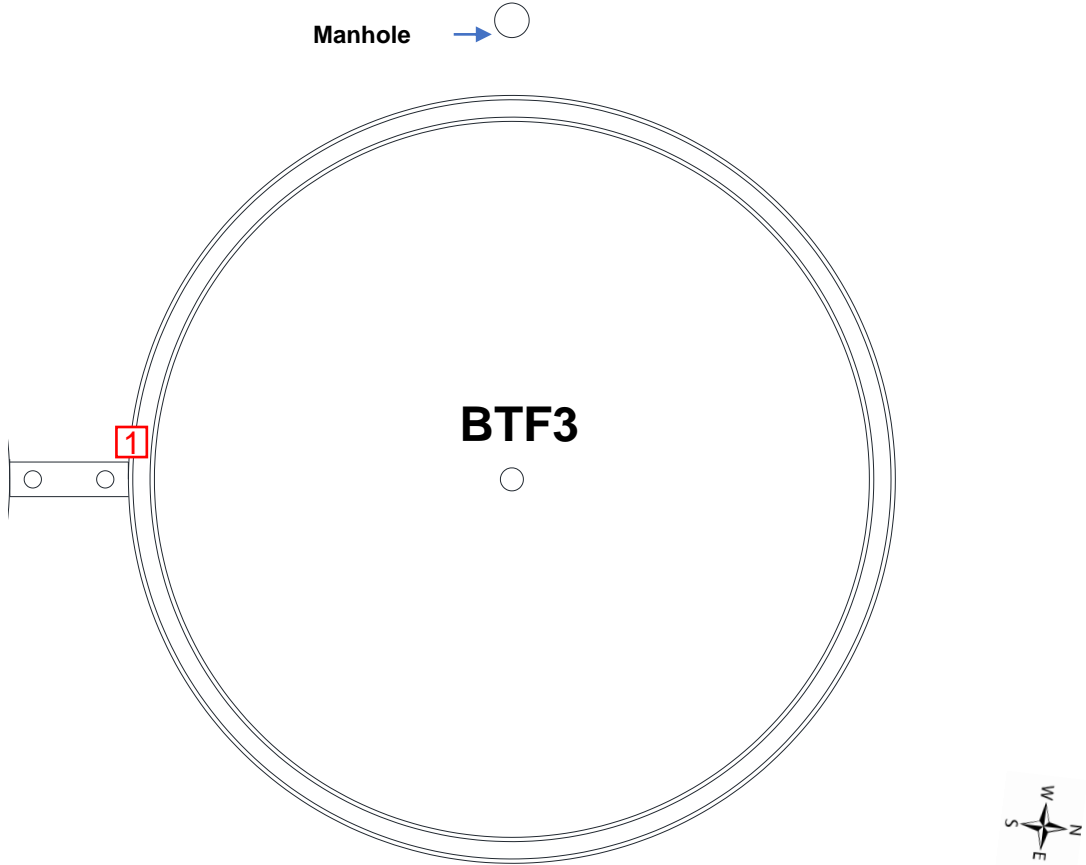


REPAIR NO.	ELEMENT	DEFECT	ACTION	REPAIR AREA LENGTH (mm)	REPAIR AREA WIDTH (mm)	DEPTH/MAX CRACK WIDTH (mm)	REPAIR AREA (m <sup>2</sup> )
1	Tank wall – External	Vertical cracking	Crack injection	1000	-	0.3 to 0.5	-

# BILOELA STP REPAIR PROJECT – BTF 3



BTF 3 - Repair No. 1


# BILOELA STP REPAIR PROJECT – CHLORINE CONTACT TANK (CCT)

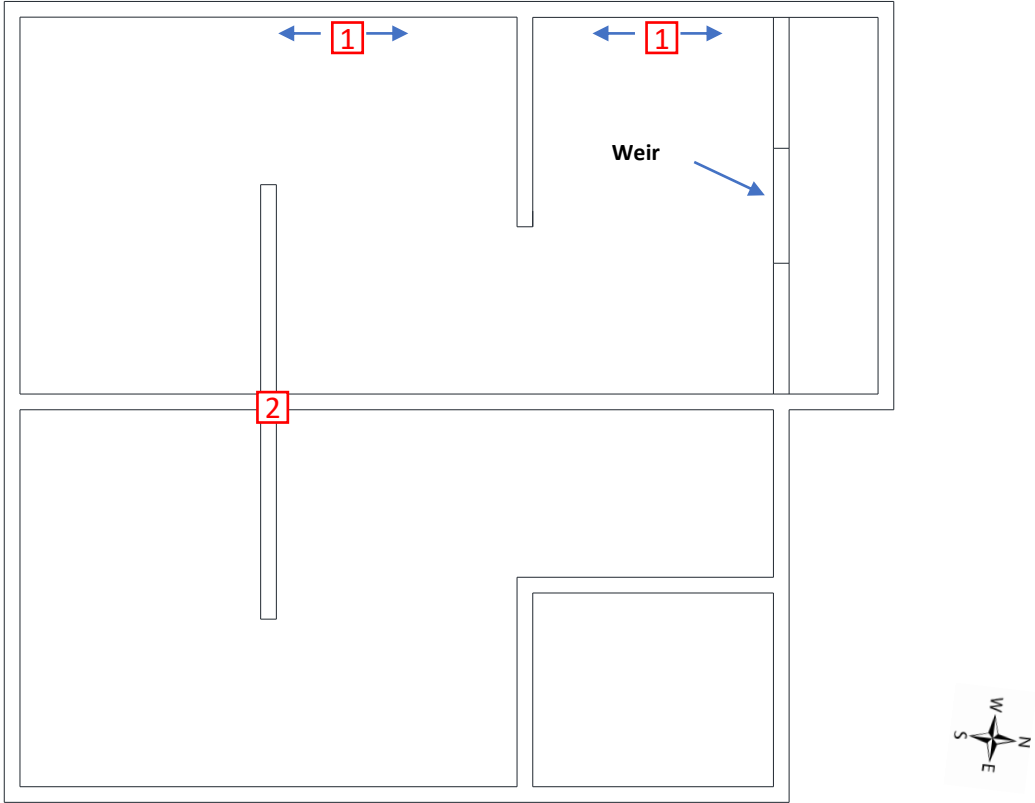

REPAIR NO.	ELEMENT	DEFECT	ACTION	REPAIR AREA LENGTH (mm)	REPAIR AREA WIDTH (mm)	DEPTH/MAX CRACK WIDTH (mm)	REPAIR AREA (m <sup>2</sup> )
1	Tank wall - Internal	Crazing, etching and loss of fines below high water level, 10mm loss	Apply epoxy protective coating to 500mm band of perimeter and baffle walls inside tank covering etched zone at water line and above	77250	500	-	38.63
2	Tank baffle walls - Top	Cracking, minor spall at top of wall	Concrete repair	250	150	HL to 0.8*	0.04

# BILOELA STP REPAIR PROJECT – CHLORINE CONTACT TANK




CCT - Repair No. 1



CCT - Repair No. 2


# BILOELA STP REPAIR PROJECT – INLET CHANNEL

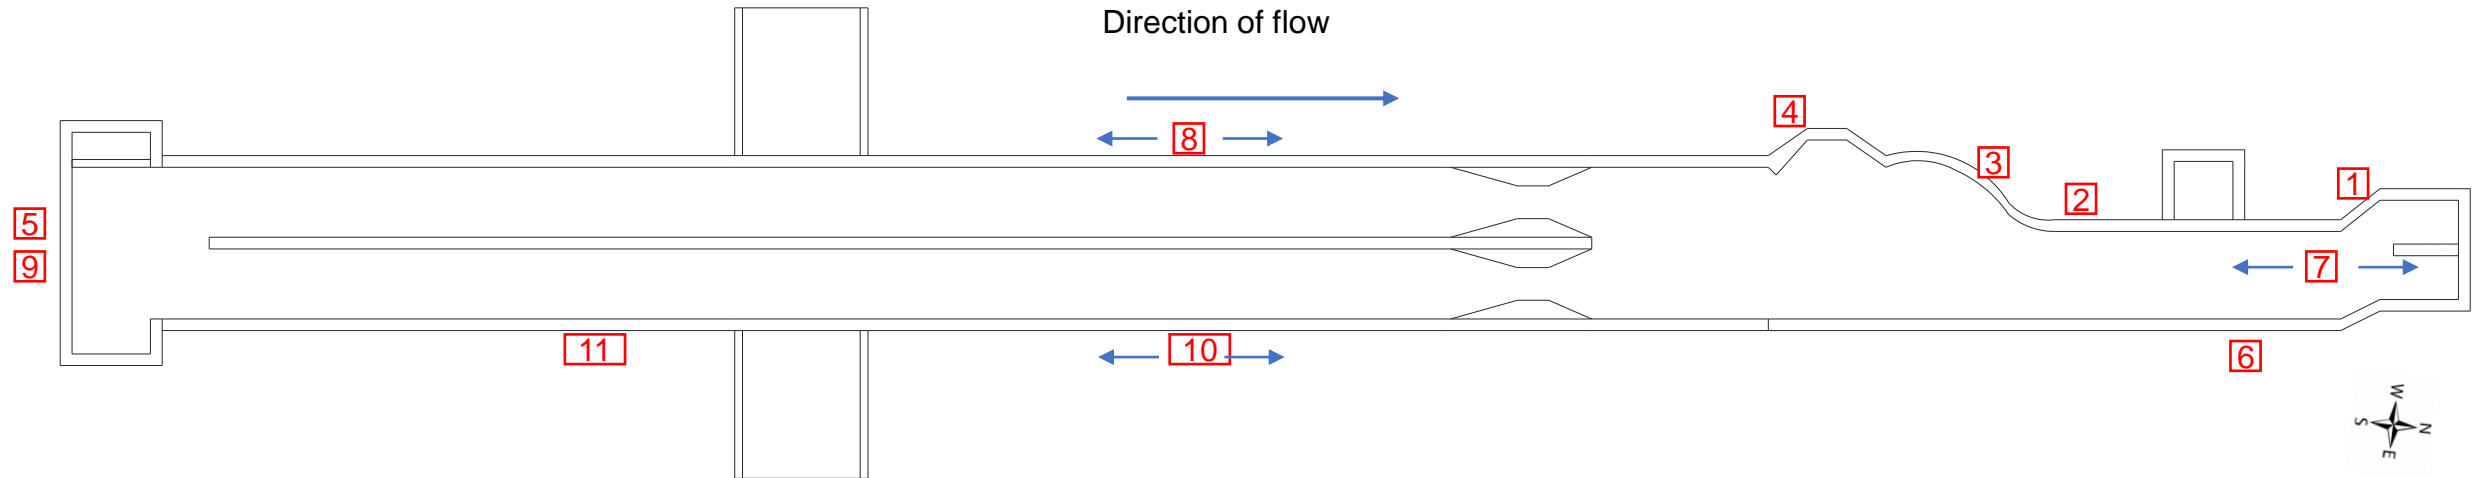

REPAIR NO.	ELEMENT	DEFECT	ACTION	REPAIR AREA LENGTH (mm)	REPAIR AREA WIDTH (mm)	DEPTH/MAX CRACK WIDTH (mm)	REPAIR AREA (m <sup>2</sup> )
1	Channel wall - External	Delamination	Concrete repair	1100	125	25	0.14
2	Channel wall - External	Delamination	Concrete repair	3000	125	25	0.38
3	Channel wall - External	Delamination and cracking	Concrete repair	400	125	-	0.05
4	Channel wall - External	Delamination and cracking	Concrete repair	1500	150	-	0.23
5	Channel wall - External	Delamination	Concrete repair	800	100	-	0.08
6	Channel wall - External	Delamination and cracking	Concrete repair	900	125	150	0.11
7	Channel wall - Internal	Etching to internal surface, approximately 3m <sup>2</sup> of concrete section loss around waterline and outlet	Apply epoxy protective coating to full internal surface of walls (excl. floor)	-	-	-	93.00
8	Channel wall - External	Vertical cracking	Crack injection	500 x 16 cracks	-	HL to 0.8	-
9	Channel wall - External	Radial cracking	Crack injection	500 x 2 cracks	-	0.35 to 0.8	-

# BILOELA STP REPAIR PROJECT – INLET CHANNEL

REPAIR NO.	ELEMENT	DEFECT	ACTION	REPAIR AREA LENGTH (mm)	REPAIR AREA WIDTH (mm)	DEPTH/MAX CRACK WIDTH (mm)	REPAIR AREA (m <sup>2</sup> )
10	Channel wall - External	Vertical cracking	Crack injection	500 x 25 cracks	-	HL to 0.5	-
11	Channel Wall - External	Carbonation to external surface	Apply anti-carbonation coating to full external surface of perimeter walls including top of perimeter wall	-	-	-	53.00



# BILOELA STP REPAIR PROJECT – INLET CHANNEL




Inlet Channel - Repair No. 1



Inlet Channel - Repair No. 2



Inlet Channel - Repair No. 3

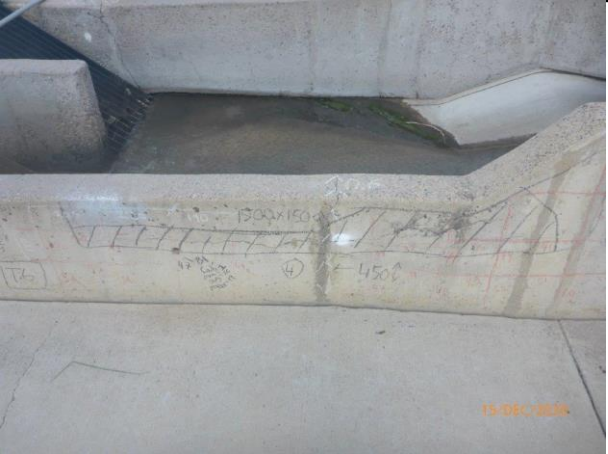

Inlet Channel - Repair No. 4



Inlet Channel - Repair No. 5



Inlet Channel - Repair No. 6



Inlet Channel - Repair No. 7




Inlet Channel - Repair No. 8



Inlet Channel - Repair No. 9



Inlet Channel - Repair No. 10

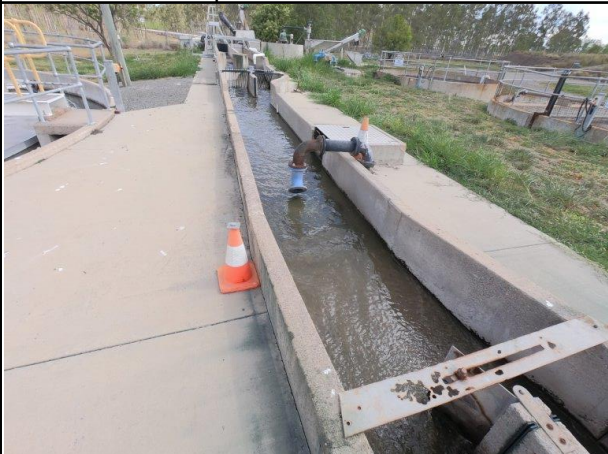

Inlet Channel - Repair No. 11

**APPENDIX B – BTF2 REPLACEMENT WALL AND BTF 3 RESTRAINT  
BRACKET CONCEPT DESIGNS**

## GENERAL

- ALL DESIGNS ARE CONCEPT AND NOT FOR CONSTRUCTION,
- DO NOT SCALE THE DRAWINGS,
- UNLESS NOTED OTHERWISE:
  - ALL DIMENSIONS ARE IN MILLIMETERS,
  - ALL RLS ARE SHOWN IN METERS (AHD),
- THESE DRAWINGS TO BE READ IN CONJUNCTION WITH THE ORIGINAL AS-CONSTRUCTED DRAWINGS FOR BILOELA STP.
- ALL WORKMANSHIP AND MATERIALS SHALL BE IN ACCORDANCE WITH THE RELEVANT AND CURRENT AUSTRALIAN STANDARDS AND THE REQUIREMENTS OF THE RELEVANT LOCAL STATUTORY AUTHORITIES' REGULATIONS INCLUDING ALL AMENDMENTS, EXCEPT WHERE VARIED BY THE PROJECT SPECIFICATION.
- NOMINATION OF PROPRIETARY ITEMS DOES NOT INDICATE EXCLUSIVE PREFERENCE BUT INDICATES THE REQUIRED PROPERTIES OF THE ITEM.
- SIMILAR ALTERNATIVES WITH THE REQUIRED PROPERTIES MAY BE OFFERED FOR WRITTEN APPROVAL.
- TRADE NAMES HAVE BEEN USED ONLY TO ESTABLISH A BASIC REQUIREMENT AND ANY SATISFACTORY EQUIVALENT MAY BE SUBMITTED FOR REVIEW.
- ALL PRODUCTS SHALL BE INSTALLED IN STRICT ACCORDANCE WITH THE MANUFACTURER'S RECOMMENDATIONS.
- ALL STANDARD DRAWINGS SHALL BE CONSIDERED GENERIC IN NATURE AND MAY NOT BE DEPICTED IN CLOSE RESEMBLANCE TO THE APPLICABLE STRUCTURE. THE CONTRACTOR SHALL REMAIN RESPONSIBLE FOR READING THE STANDARD DRAWINGS IN CONJUNCTION WITH OTHER DESIGN DRAWINGS.
- IT IS THE CONTRACTORS RESPONSIBILITY TO CONFIRM ALL DIMENSIONS (AND LEVELS) OF EXISTING STRUCTURES PRIOR TO FABRICATION AND INSTALLATION.
- DESIGN LOADS HAVE BEEN CALCULATED IN ACCORDANCE WITH AS1170 PART 1.

## REINFORCEMENT

- REINFORCEMENT SHOWN ON THE DRAWINGS IS REPRESENTED DIAGRAMMATICALLY AND NOT NECESSARILY SHOWN IN TRUE PROJECTION.
- REINFORCEMENT SYMBOLS INDICATE THE FOLLOWING: N - DENOTES GRADE 500N HOT ROLLED DEFORMED REINFORCEMENT BARS TO AS 4671.
- REINFORCEMENT NOTATION:  
EXAMPLE N16-300  
N - DEFORMED CLASS N BAR  
16 - BAR SIZE IN MILLIMETERS  
300 - SPACING OF BARS
- ALL REINFORCING STEEL SHALL BE ACRS (AUSTRALIAN CERTIFICATION AUTHORITY FOR REINFORCING AND STRUCTURAL STEEL) CERTIFIED.
- SITE REBENDING OF REINFORCEMENT BY MECHANICAL OR ANY OTHER MEANS IS NOT PERMITTED WITHOUT THE APPROVAL OF THE DESIGNER.
- REINFORCEMENT SHALL BE LAPPED ONLY IN THE LOCATIONS SHOWN ON THE IFC DRAWINGS OR AS OTHERWISE APPROVED BY THE DESIGNER. WHERE THE LAP LENGTH IS NOT SHOWN IT SHALL BE SUFFICIENT TO DEVELOP THE FULL STRENGTH OF THE REINFORCEMENT. BAR LAP LENGTHS SHALL BE AS SHOWN IN THE TABLE BELOW (U.N.O.):

BAR DIAMETER	HORIZONTAL BARS WITH >300 CONCRETE BELOW BAR	ALL OTHER BARS
12	550	400
16	700	550
20	1000	800
24	1350	1050
28	1750	1350
32	2150	1650

- REINFORCEMENT SHALL NOT BE WELDED UNLESS SHOWN ON THE DRAWINGS OR APPROVED BY THE DESIGNER.
- ALL REINFORCEMENT SHALL BE SECURELY SUPPORTED ON CONCRETE SPACERS (MADE FROM SOUND CONCRETE OF SAME STRENGTH OR GREATER AS THE CONCRETE ELEMENT BEING USED IN) OR PLASTIVE TIPPED WIRE CHAIRS CONFORMING TO AS/NZS 2425 AT NOT GREATER THAN 1 METER CENTRES EACH WAY. ALL REINFORCEMENT SHALL BE SECURELY TIED WITH WIRE TIES. TIE ENDS SHALL NOT EXTEND INTO THE COVER ZONE.
- THE SUPERINTENDENT SHALL BE GIVEN A MINIMUM OF 48 HOURS NOTICE FOR REINFORCEMENT INSPECTIONS AND CONCRETE SHALL NOT BE DELIVERED UNTIL FINAL APPROVAL IS OBTAINED.

## CONCRETE

- CONCRETE, CONCRETE WORK, AND STEEL REINFORCEMENT SHALL CONFORM TO AS3600, AS1379.
- CONCRETE STRENGTH GRADE (MINIMUM N40), CONCRETE MIX DESIGN AND COVER REQUIREMENTS (EXPOSURE CLASSIFICATIONS) SHALL BE DETERMINED DURING DETAILED DESIGN AND PRIOR TO CONSTRUCTION.
- ALL FORMED EXPOSED EDGES AND RE-ENTRANT CORNERS SHALL BE CHAMFERED OR FILLETED 20mm U.N.O.
- NO PENETRATIONS, CHASES OR TEMPORARY FIXTURES OTHER THAN THOSE SHOWN ON THE DRAWINGS ARE PERMITTED IN THE CONCRETE MEMBERS WITHOUT PRIOR APPROVAL OF THE STRUCTURAL ENGINEER.
- ALL FORMWORK MATERIALS, WORKMANSHIP AND STRIPPING OF FORMWORK SHALL BE IN ACCORDANCE WITH AS3600 AND AS3610 INCLUDING ALL AMENDMENTS AND SUPPLEMENTS.
- THE CONTRACTOR SHALL BE RESPONSIBLE FOR THE DESIGN, CERTIFICATION, CONSTRUCTION AND PERFORMANCE OF ALL FORMWORK AND FALSEWORK.
- CONCRETE SURFACES SHALL BE FREE FROM ALL CURING COMPOUNDS, FORM OIL, DUST, DIRT AND FOREIGN MATTER.
- CONSTRUCTION JOINTS SHALL BE WET DOWN OR SOAKED THOROUGHLY IMMEDIATELY PRIOR TO POURING CONCRETE AGAINST THE SURFACE.
- ALL CONCRETE INTERFACES SHALL BE ROUGHENED TO ENSURE SATISFACTORY BOND BETWEEN DIFFERENT POURS OF INSITU CONCRETE U.N.O. AT ALL CONSTRUCTION JOINTS(C.J) ALL LAITANCE WILL BE COMPLETELY REMOVED FROM THE CONTACT FACE AND COARSE AGGREGATE EXPOSED, BUT LEAVING IT FIRMLY EMBEDDED IN THE MORTAR MIX, TO A DEPTH OF 6mm BEFORE THE ADJACENT SECTION IS POURED. WHERE AN ADJACENT FACE OF THE CONCRETE IS TO BE EXPOSED IN THE FINISHED WORKS, TREATMENT OF THE JOINT WILL BE TERMINATED 12mm AWAY FROM THE EXPOSED FACE.
- CONCRETE SHALL BE SUPPLIED ON A PERFORMANCE BASIS TO THE CONCRETE GRADES NOTED ON THE DESIGN DRAWINGS. CONCRETE MIX DESIGN, INCLUDING PROPORTIONS OF ADDITIVES AND CEMENTITIOUS REPLACEMENT MATERIALS, SHALL BE SUBMITTED TO THE DESIGNER FOR APPROVAL PRIOR TO THE PLACEMENT.
- THE FINISHED CONCRETE SHALL BE A DENSE HOMOGENEOUS MASS COMPLETELY FILLING THE FORMWORK, THOROUGHLY EMBEDDING THE REINFORCEMENT AND FREE OF ANY STONE POCKETS OR VOIDS. CONCRETE SHALL BE VIBRATED BY MECHANICAL VIBRATORS DURING PLACEMENT.
- COMPLIANCE TESTING AND SAMPLING OF CONCRETE SHALL BE IN ACCORDANCE WITH AS3600, AS1379, AS1012, AND THE PROJECT SPECIFICATION.

## STAINLESS STEEL

- STAINLESS STEEL (S/S) GRADE (304, 304L, 316, 316L) SHALL BE DETERMINED DURING DETAILED DESIGN.
- ALL WELDS SHALL BE MINIMUM 6 CFW U.N.O.
- STAINLESS STEEL BOLTS SHALL BE GRADE A4-70 U.N.O.
- ANY CONNECTIONS BETWEEN DISSIMILAR METALS SHALL BE SEPARATED BY USING NEOPRENE OR NYLON SEPARATORS.
- MINIMUM CONNECTIONS SHALL BE 2/M16(S/S) BOLTS U.N.O.
- SHOP DRAWINGS SHALL BE SUBMITTED TO THE DESIGNER BEFORE COMMENCEMENT OF FABRICATION.
- ALL STAINLESS STEEL MATERIALS SHALL NOT BE STORED OR BROUGHT INTO CONTACT WITH ANY CARBON STEEL OR OTHER FERROUS METALS INCLUDING TOOLS;
- STAINLESS STEEL SHEET AND PLATE TO ASTM A240.
- STAINLESS STEEL FLAT BAR AND ROUND BAR TO ASTM A276.
- ALL STAINLESS STEEL BOLTS TO CLASS 2 B8M TO ASTM A193.
- STAINLESS STEEL SET SCREWS TO AS/NZS ISO 3506.3.
- WELDING ELECTRODES SHALL BE THE SAME S/S GRADE AS THE MATERIAL.
- WELDS SHALL BE CATEGORY 2B IN ACCORDANCE WITH AS1554.6 TABLE 6.1. THE EXTENT OF NON-DESTRUCTIVE EXAMINATION OF WELDS WILL BE IN ACCORDANCE WITH AS1554.6 TABLE 7.4.
- AFTER FABRICATION, PICKLING AND PASSIVATION WILL BE IN ACCORDANCE WITH ASTM A380.
- WELDER SHALL BE QUALIFIED AND PERFORMED IN ACCORDANCE WITH AS/NZS 1554.6;
- EDGES TO BE PROTECTIVE TREATED SHALL BE ROUNDED TO A RADIUS OF 1.5mm U.N.O.
- TO PROVIDE RESISTANCE TO PITTING CORROSION AND TEA STAINING, THE SURFACE ROUGHNESS (RA) SHALL BE <0.5 MICRONS. DEPENDING ON THE PRODUCT, THE FOLLOWING SURFACE FINISHES ARE ACCEPTABLE:

"2B (COLD ROLLED)" - FLAT SHEET OR COIL <5mm THICK

"NO. 4 (POLISHED)" - ALL OTHER PRODUCTS

## CHEMICAL ANCHORS

- ALL ANCHORS MUST COMPLY WITH THE REQUIREMENTS OF SA TS 01:2015/ AS5216:2018 STANDARD.
- ALL FASTENERS MUST BE INSTALLED IN ACCORDANCE WITH THE MANUFACTURER'S INSTALLATION INSTRUCTIONS USING THE TOOLS WHICH ARE INDICATED IN THE PRODUCT'S TEST REPORT.
- INSTALLATION SHALL BE PERFORMED BY AN 'AEFAC' CERTIFIED INSTALLER OR BY A PERSON TRAINED BY THE MANUFACTURER/ SUPPLIER OF THE SPECIFIED PRODUCT.
- ALL ANCHOR HOLES MUST BE HAMMER DRILLED.
- THE DESIGN ENGINEER MUST BE CONSULTED FOR THE APPROVAL OF AN ALTERNATE PRODUCT OR DRILLING METHOD.
- EPOXIES USED TO FIX CHEMICAL ANCHORS INTO SOLID CONCRETE SHALL BE HILTI RE-500V3 U.N.O.
- ALL ANCHOR STUDS SHALL BE FULLY THREADED STAINLESS STEEL A4-70 STUDS U.N.O.



## TEMPORARY WORKS

- ALL COMPONENTS TO BE RETAINED (INCLUDING BUT NOT LIMITED TO CONCRETE STRUCTURE, INTERCONNECTING PIPE WORK, MECHANICAL EQUIPMENT ETC) SHALL BE ADEQUATELY SUPPORTED AND PROTECTED DURING DEMOLITION OF NOMINATED PARTS AND CONSTRUCTION TO PREVENT DAMAGE, OVERSTRESSING, MOVEMENT AND/OR COLLAPSE.
- ALL TEMPORARY WORKS SHALL BE THE RESPONSIBILITY OF THE CONTRACTOR.
- IF IN DOUBT, THE CONTRACTOR SHALL RAISE CONCERNS REGARDING THE INTEGRITY OF EXISTING INFRASTRUCTURE TO THE CLIENT SUPERINTENDENT AND RECEIVE CLARIFICATION PRIOR TO PROCEEDING. CONCERNS REGARDING STABILITY OF THE EXISTING INFRASTRUCTURE DOES NOT FORM GROUNDS FOR A VARIATION WITH THE CLIENT.
- ALL TEMPORARY WORKS SHALL BE CERTIFIED BY THE CONTRACTOR'S APPROPRIATELY QUALIFIED ENGINEER PRIOR TO PROCEEDING.








## LEGEND TO NOTATION ON DRAWINGS

EF - EACH FACE	C.J - CONSTRUCTION JOINT
NF - NEAR FACE	U.N.O - UNLESS NOTED OTHERWISE
FF - FAR FACE	FW - FILLET WELD
EW - EACH WAY	S/S - STAINLESS STEEL
T OR TOP - TOP	U.S - UNDERSIDE
B OR BTM- BOTTOM	CFW - CONTINUOUS FILLET WELD
CPBW - QUALIFIED COMPLETE PENETRATION BUTT WELD	

**CONCEPT**  
**NOT FOR CONSTRUCTION**  
14 December 2021

DRAWING FILE LOCATION / NAME		PLOT DATE		TIME										
V:\_Vault\Projects\3003\30032680\110_CADD\CAD\DWG\30032680-GA-1121.dwg		14 Dec 2021		11:20:04										
EXTERNAL REFERENCE FILES	REV	DATE	AMENDMENT / REVISION DESCRIPTION	WVR No.	APPROVAL	TITLE	NAME	SCALES AT A1 SIZE DRAWING	DESIGNER	CLIENT	PROJECT TITLE			
	01	14/12/2021	ISSUED FOR CONCEPT		BK	DRAFTER	D LOOKER		 Member of the Surbana Jurong Group © ABN 47 065 475 149  SMC PROJECT No 30032680		BILOELA STP  STRUCTURAL GENERAL NOTES			
					DRAFTING CHECK	C HAYWOOD								
					DESIGNER	C HAYWOOD								
					DESIGN CHECK	A MOORE								
					PROJECT MANAGER	P LARKIN								
					PROJECT DIRECTOR	M DUNCAISON								
											SCALE	PHASE	PROJECT / DRAWING No.	REVISION
											AS NOTED	CONCEPT	30032680-GA-1121	-


**CONCEPT**  
NOT FOR CONSTRUCTION  
14 December 2021

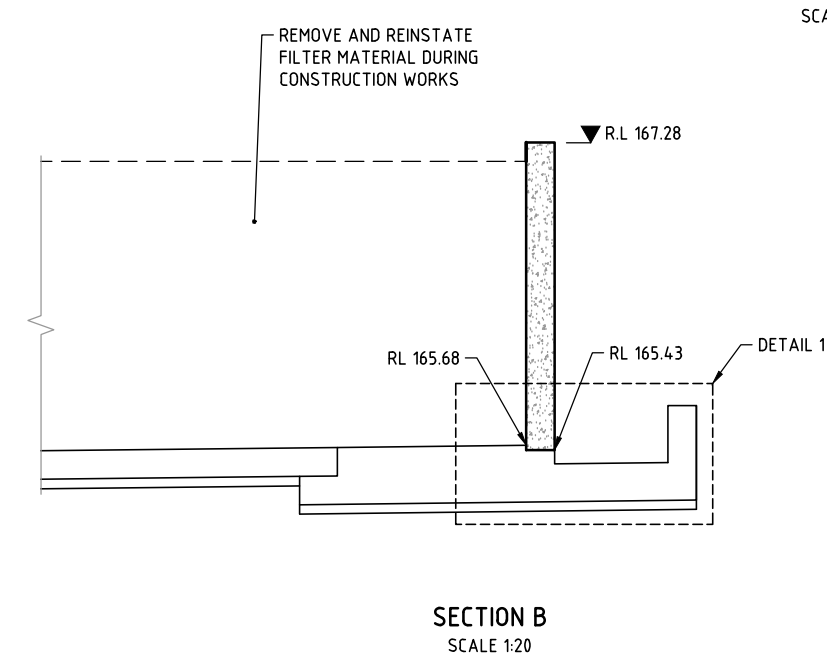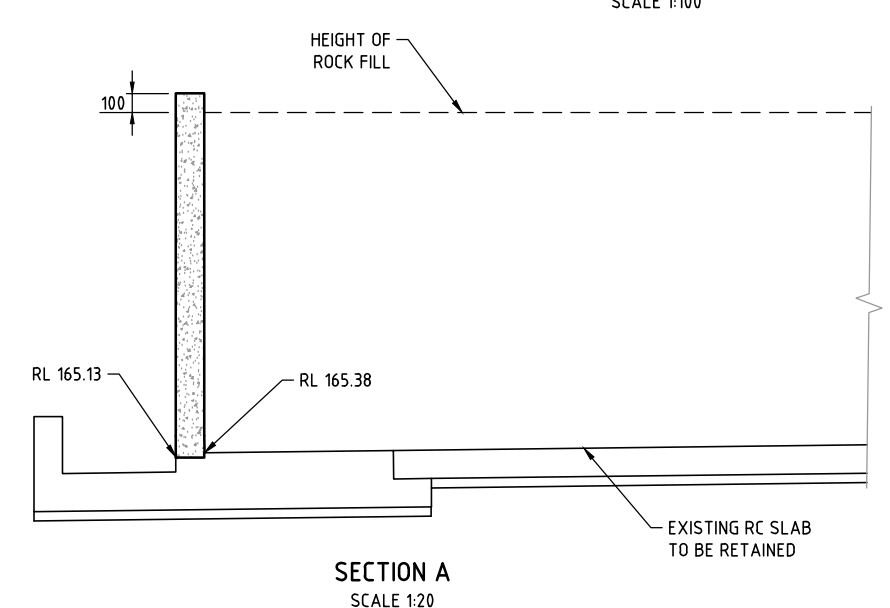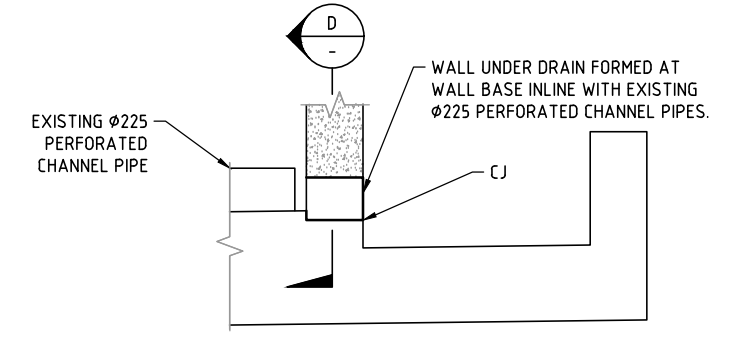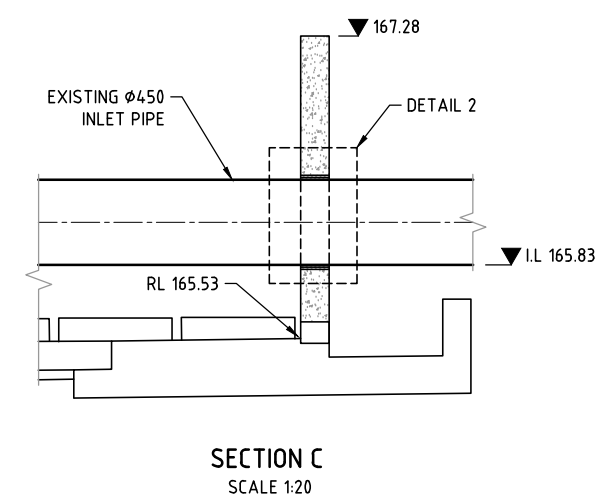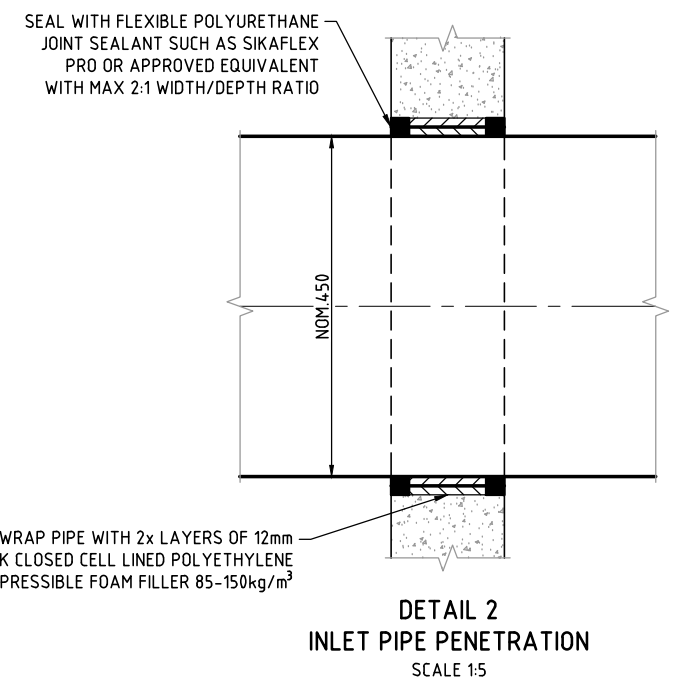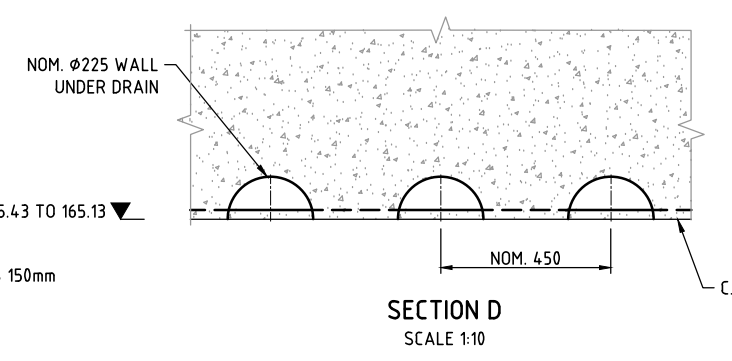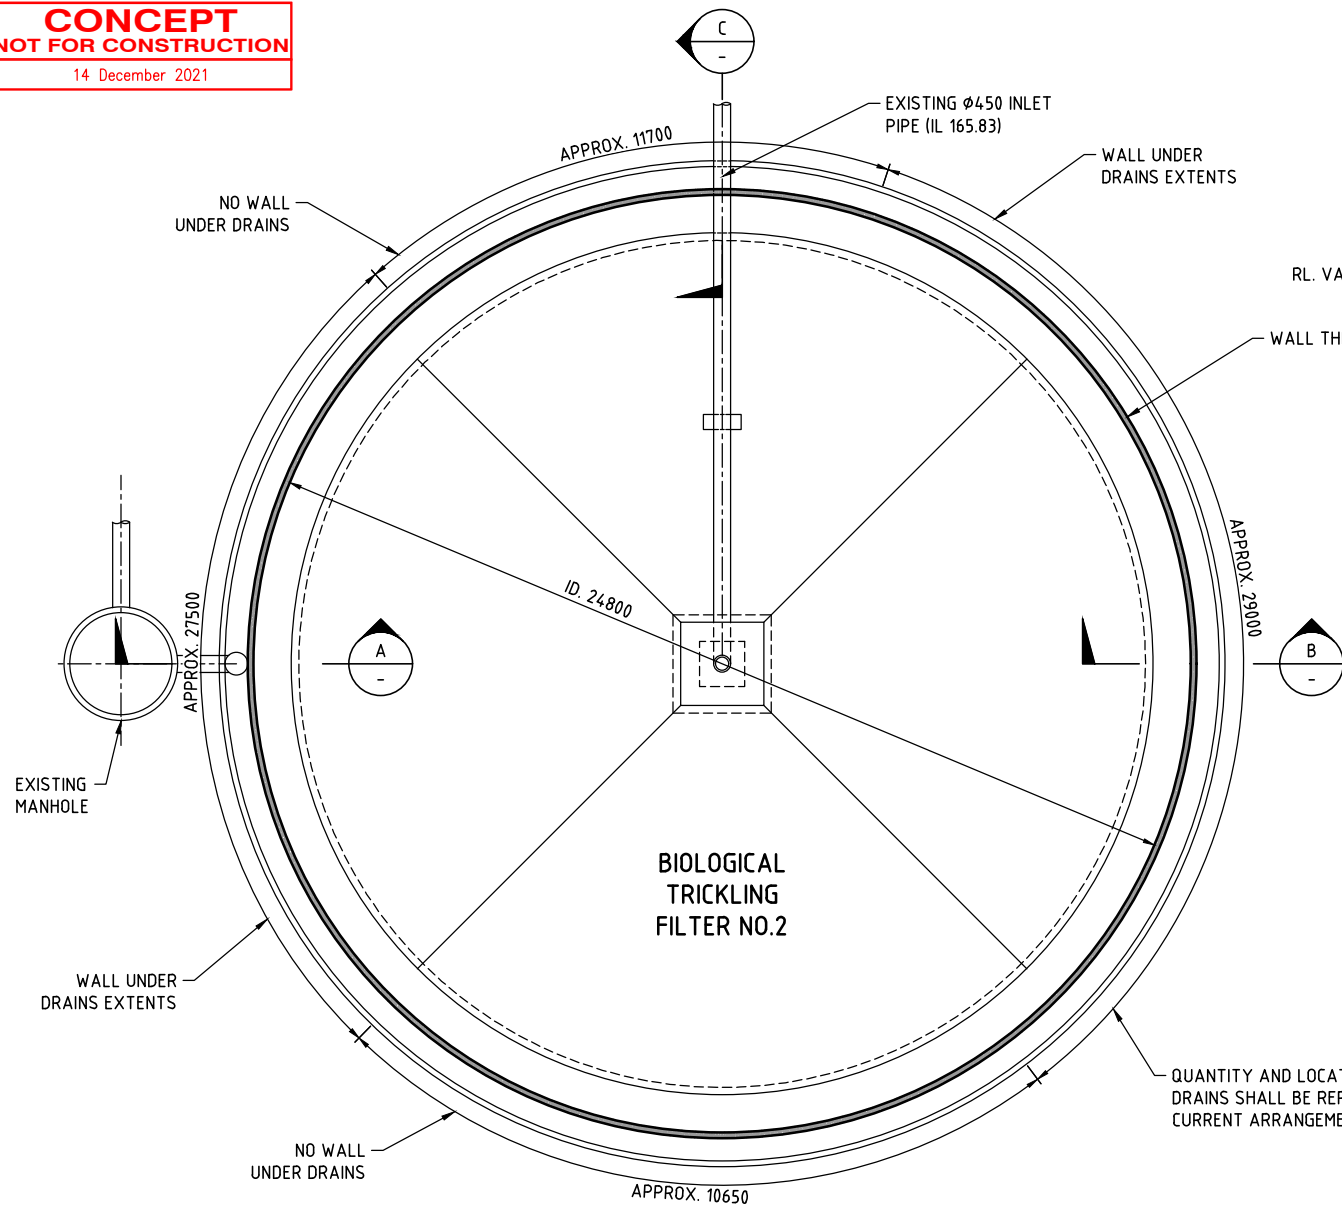


- NOTES**
- FOR GENERAL NOTES REFER TO DRG No. 30032680-GA-1121.
  - FOR REINFORCEMENT DETAILS REFER TO DRG No. 30032680-GA-1123.
  - ALL STRUCTURAL DETAILS REFER TO DRG No. 30032680-GA-1122.
  - CONTRACTOR/DESIGNER MAY CONSIDER AN ALTERNATIVE MEANS OF CONSTRUCTION/RESTRAINT IN THE REINSTATEMENT OF THE BTF WALL.

DRAWING FILE LOCATION / NAME V:\_Vault\Projects\3003\30032680\110_CADD\CAD\DWG\30032680-GA-1122.dwg		PLOT DATE 14 Dec 2021		TIME 11:20:31	
EXTERNAL REFERENCE FILES	REV	DATE	AMENDMENT / REVISION DESCRIPTION	WVR No.	APPROVAL
	01	14/12/2021	ISSUED FOR CONCEPT		BK
					DRAFTER <i>D LOOKER</i>
					DRAFTING CHECK <i>C HAYWOOD</i>
					DESIGNER <i>C HAYWOOD</i>
					DESIGN CHECK <i>A MOORE</i>
					PROJECT MANAGER <i>P LARKIN</i>
					PROJECT DIRECTOR <i>M DUNCANSON</i>
SCALES AT A1 SIZE DRAWING		DESIGNER		CLIENT	
SCALE 1:5	0 0.05 0.10 0.20	SMEC		Banana SHIRE	
SCALE 1:10	0 0.1 0.2 0.3 0.4 0.5	Member of the Surbana Jurong Group © ABN 47 065 475 149			
SCALE 1:20	0 0.2 0.4 0.6 0.8 1.0				
SCALE 1:100	0 1 2 3 4 5				
PROJECT TITLE		PROJECT / DRAWING No.		REVISION	
BILOELA STP BIOLOGICAL TRICKLING FILTER 2 - WALL REPLACEMENT REINFORCED CONCRETE GENERAL ARRANGEMENT AND DETAILS		30032680-GA-1122		-	
SCALE	PHASE	PROJECT / DRAWING No.		REVISION	
AS NOTED	CONCEPT	30032680-GA-1122		-	


**CONCEPT**  
NOT FOR CONSTRUCTION  
14 December 2021

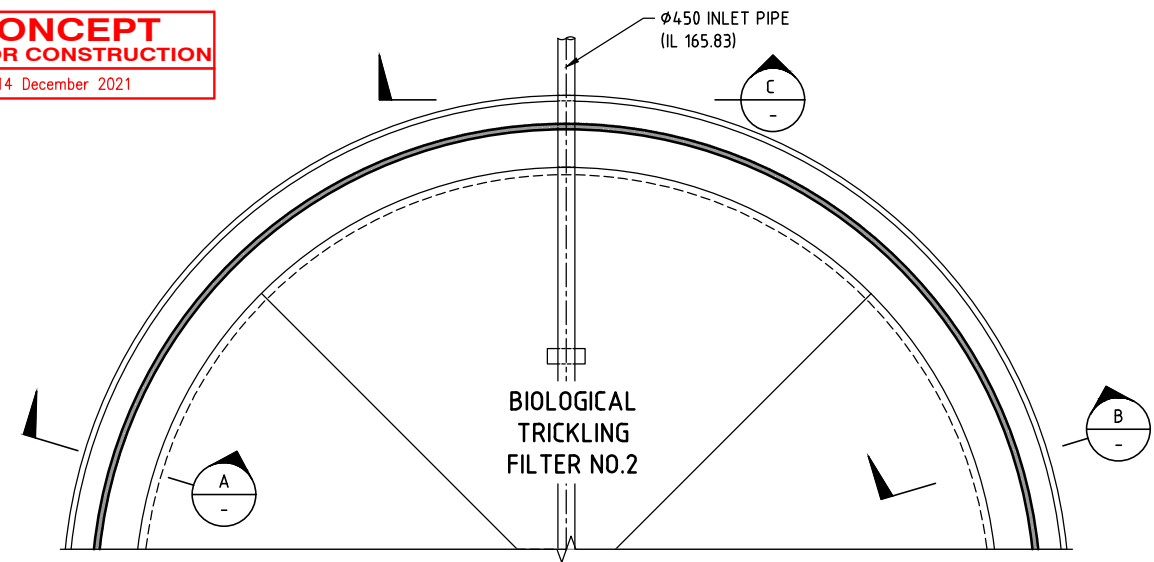


WALL PLAN COPING LEVEL (RL 167.28)  
SCALE 1:100

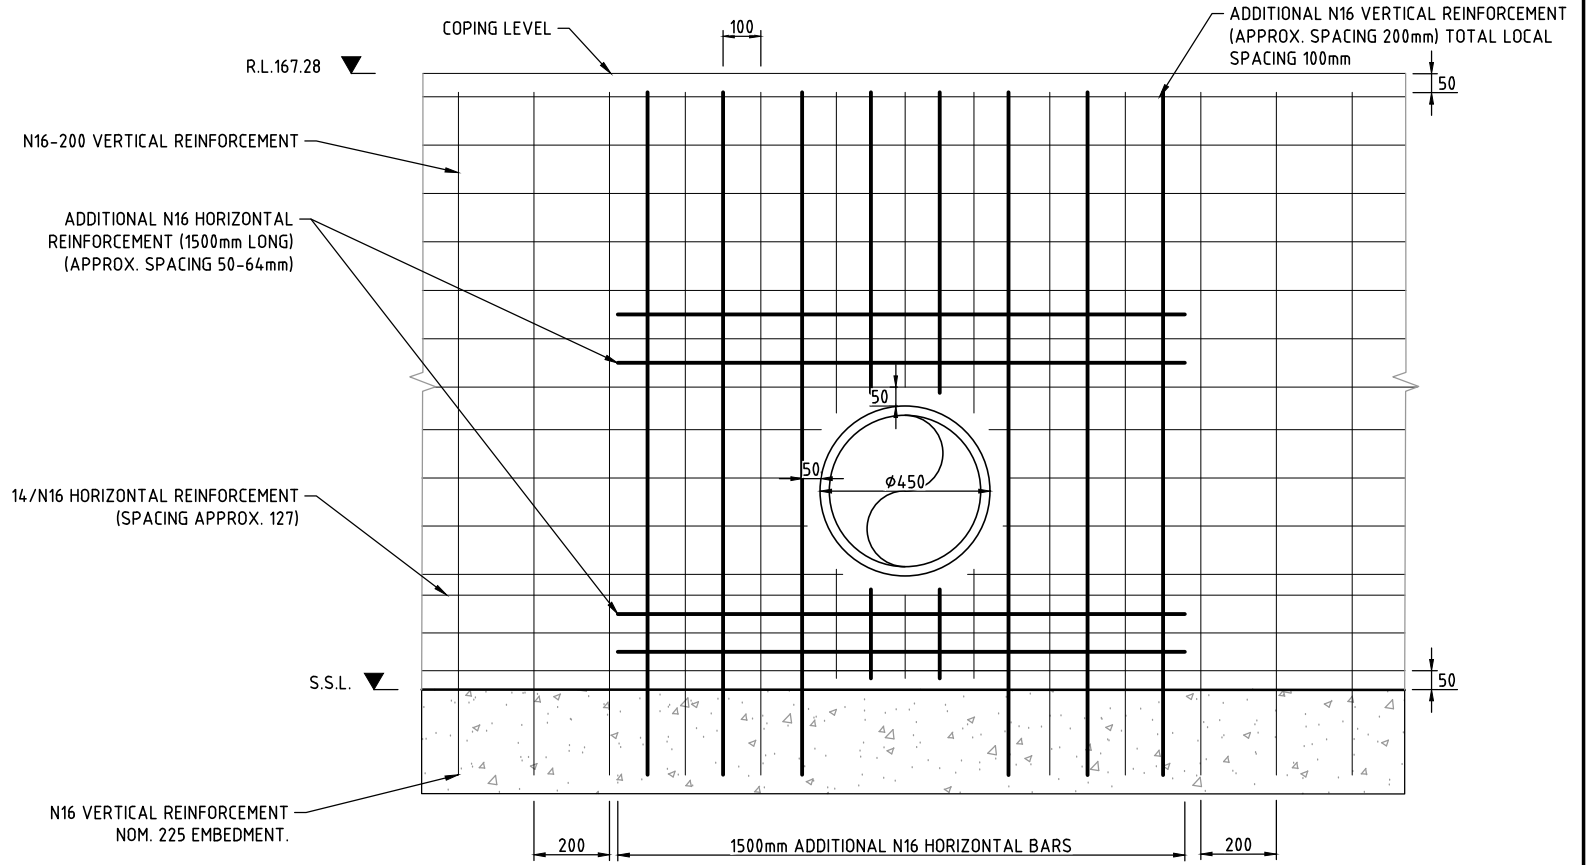


SECTION C  
SCALE 1:10

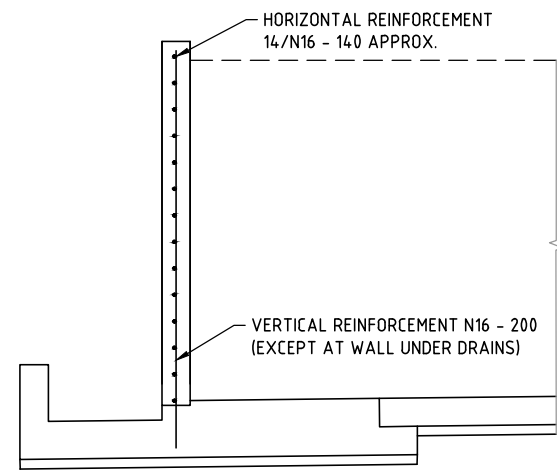


SECTION A  
SCALE 1:20

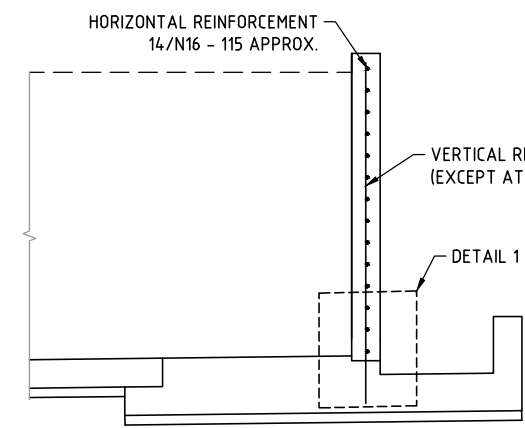

SECTION B  
SCALE 1:20

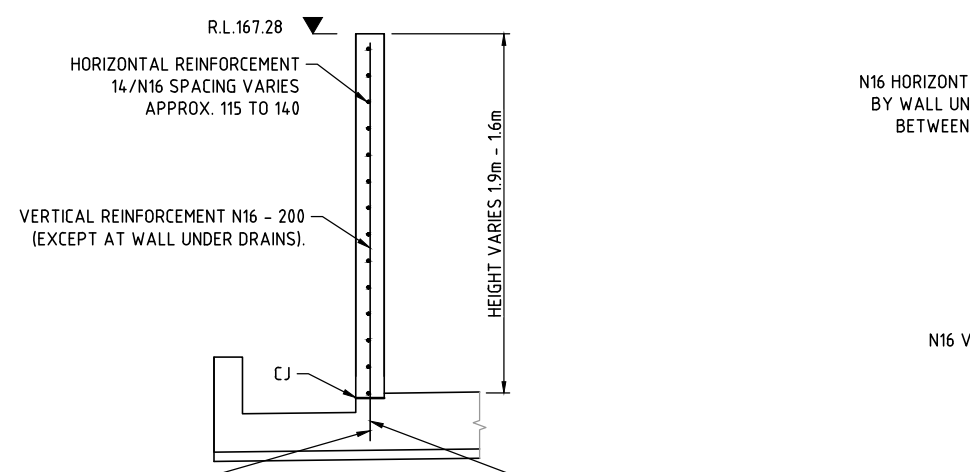

TYPICAL WALL SECTION  
SCALE 1:20

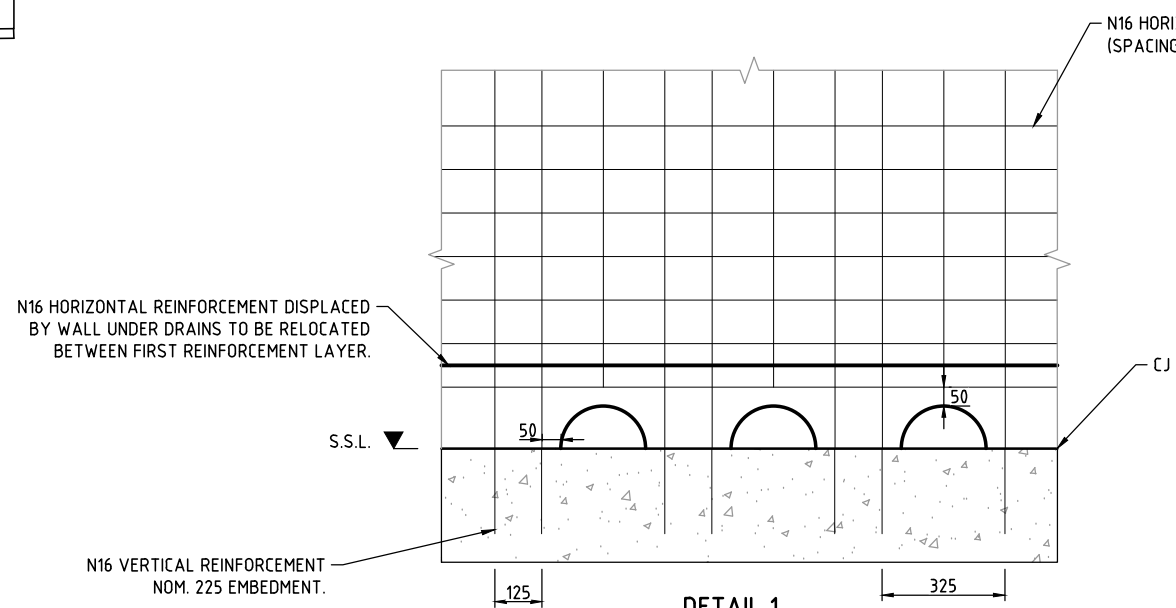


DETAIL 1  
WALL UNDER DRAIN REINFORCEMENT  
SCALE 1:10


- NOTES**
- FOR GENERAL NOTES REFER TO DRG No. 30032680-GA-1121.
  - FOR REINFORCEMENT DETAILS REFER TO DRG No. 30032680-GA-1123.
  - ALL STRUCTURAL DETAILS REFER TO DRG No. 30032680-GA-1122
  - CONTRACTOR/DISIGNER MAY CONSIDER AN ALTERNATIVE MEANS OF CONSTRUCTION/RESTRAINT IN THE REINSTATEMENT OF THE BTF WALL.

DRAWING FILE LOCATION / NAME V:\_Vault\Projects\3003\30032680\110_CADD\CAD\DWG\30032680-GA-1123.dwg		PLOT DATE 14 Dec 2021		TIME 11:20:55	
EXTERNAL REFERENCE FILES	REV	DATE	AMENDMENT / REVISION DESCRIPTION	WVR No.	APPROVAL
	01	14/12/2021	ISSUED FOR CONCEPT		BK
					DRAFTER <i>D LOOKER</i>
					DRAFTING CHECK <i>C HAYWOOD</i>
					DESIGNER <i>C HAYWOOD</i>
					DESIGN CHECK <i>A MOORE</i>
					PROJECT MANAGER <i>P LARKIN</i>
					PROJECT DIRECTOR <i>M DUNCANSON</i>
SCALES AT A1 SIZE DRAWING		DESIGNER		CLIENT	
SCALE 1:10 0 0.1 0.2 0.3 0.4 0.5		SMEC Member of the Surbana Jurong Group © ABN 47 065 475 149		Banana SHIRE	
SCALE 1:20 0 0.2 0.4 0.6 0.8 1.0		SMEC PROJECT No 30032680		PROJECT TITLE BILOELA STP BIOLOGICAL TRICKLING FILTER 2 - WALL REPLACEMENT REINFORCEMENT DETAILS	
SCALE 1:100 0 1 2 3 4 5				SCALE AS NOTED	
				PHASE CONCEPT	
				PROJECT / DRAWING No. 30032680-GA-1123	
				REVISION -	


**CONCEPT**  
NOT FOR CONSTRUCTION  
14 December 2021

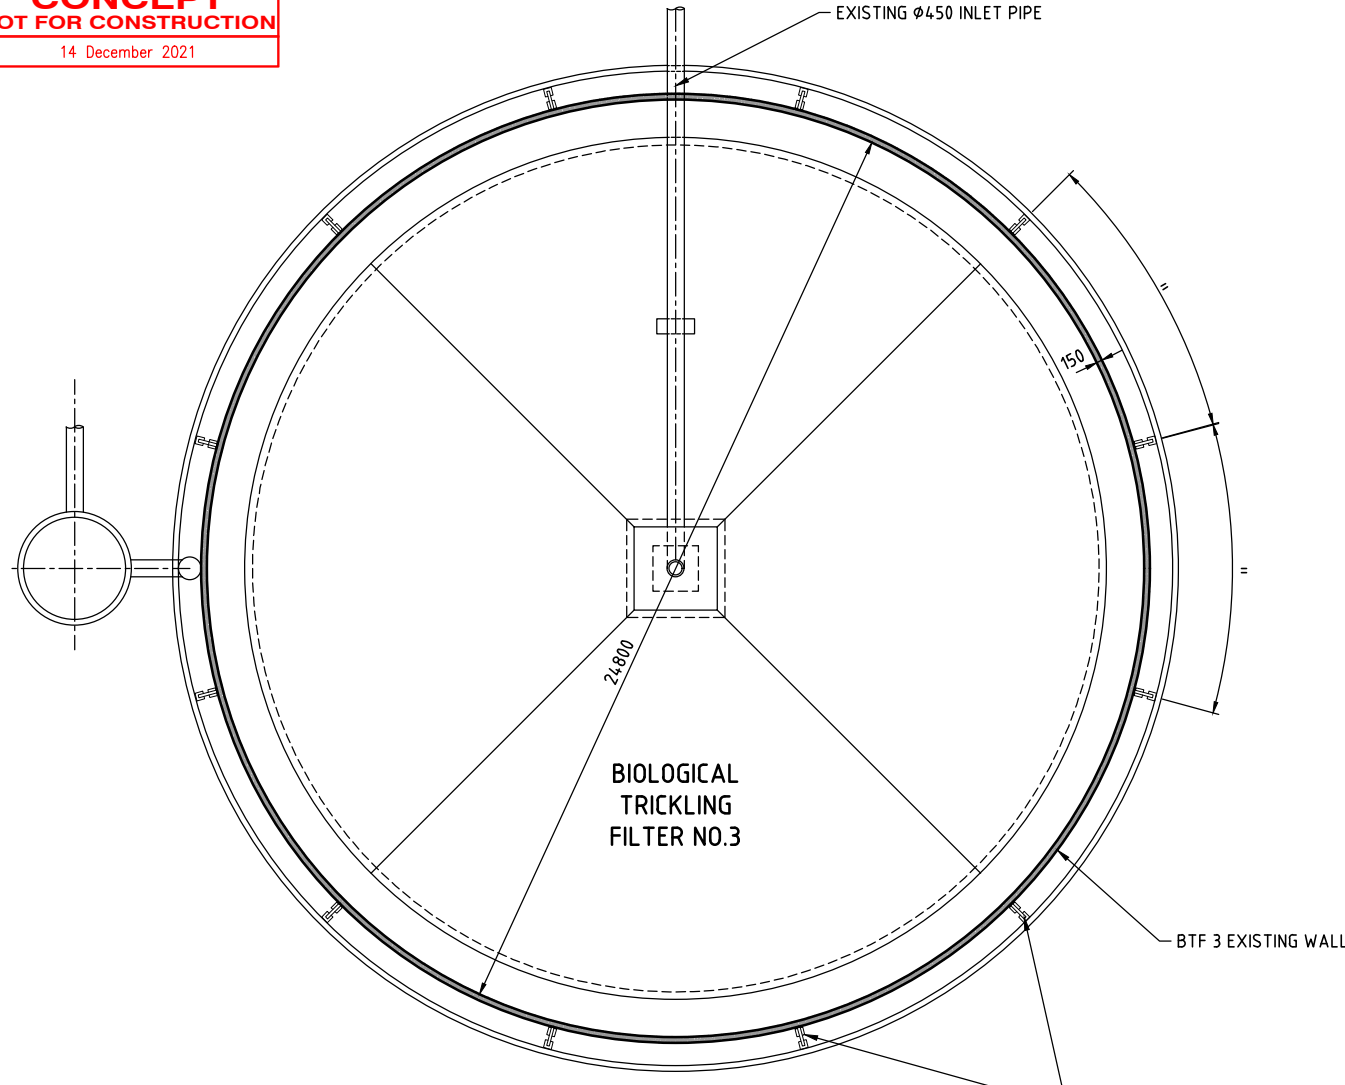


**WALL BRACKET PLACEMENT PLAN**  
SCALE 1:100

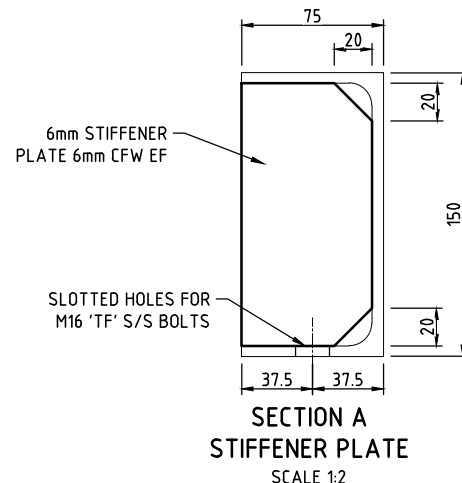


**SECTION A STIFFENER PLATE**  
SCALE 1:2

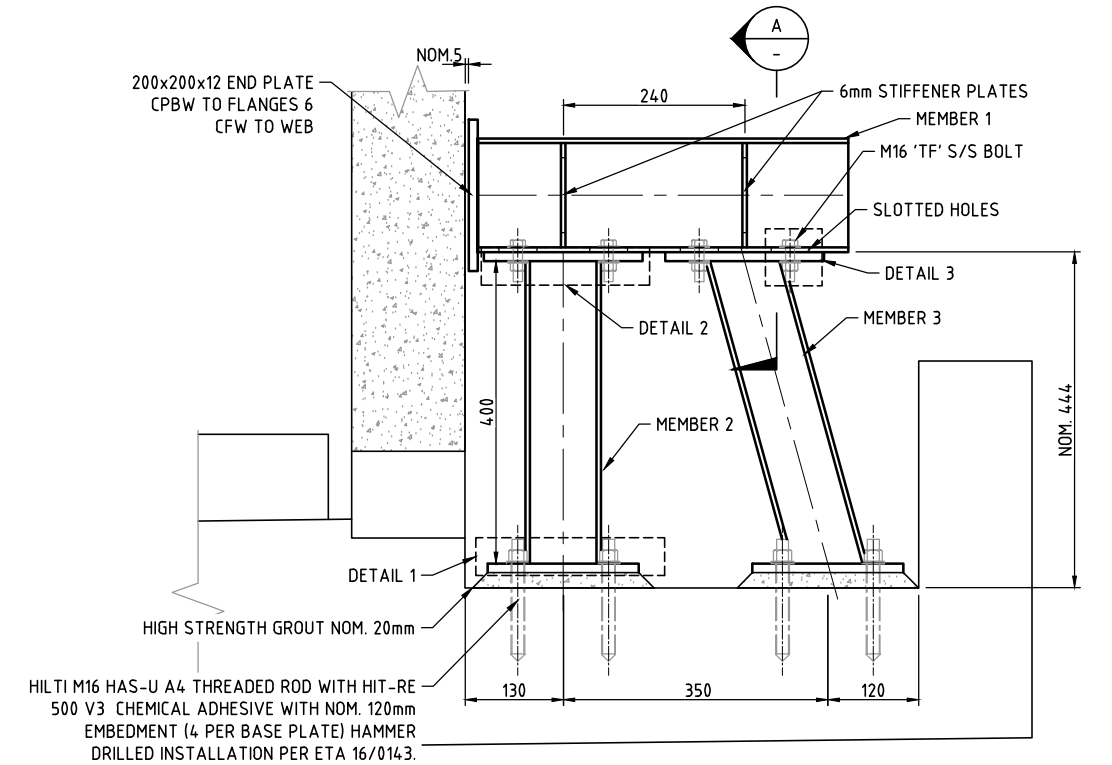


**BRACKET ELEVATION**  
SCALE 1:5

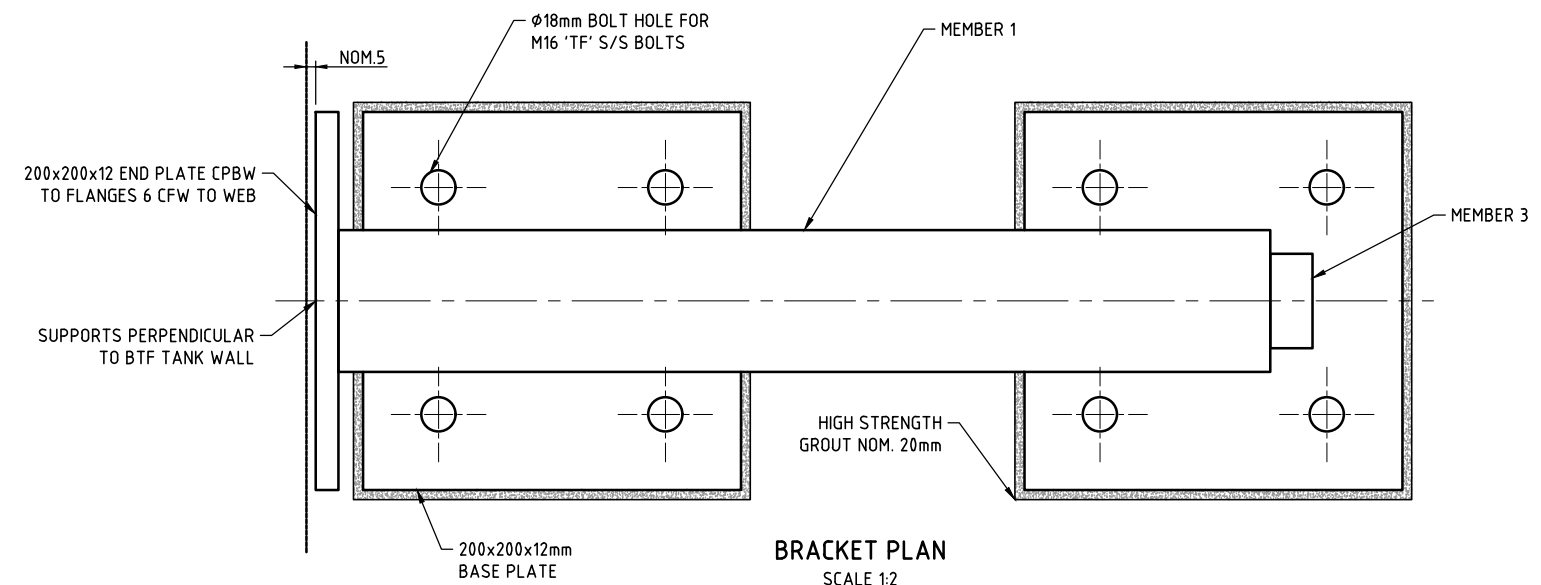


**BRACKET PLAN**  
SCALE 1:2

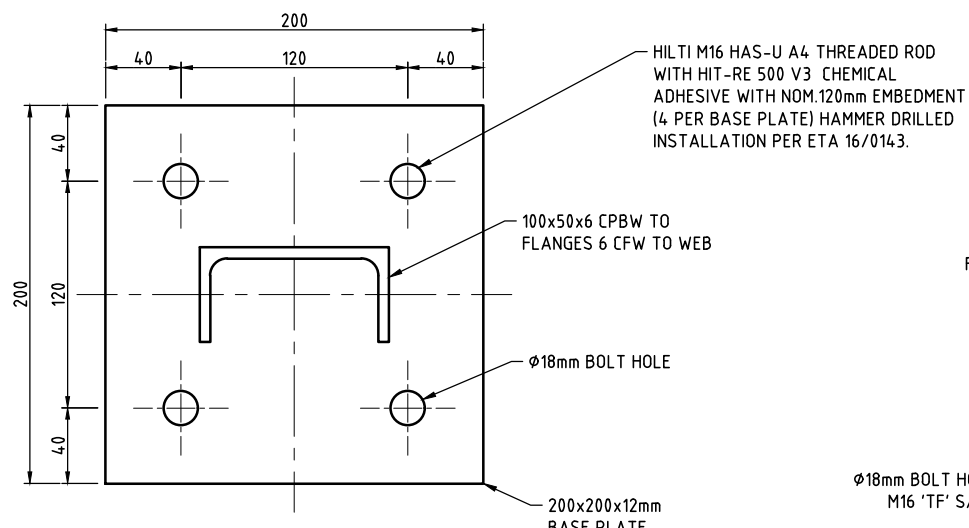

**DETAIL 1 BASE PLATE**  
SCALE 1:2

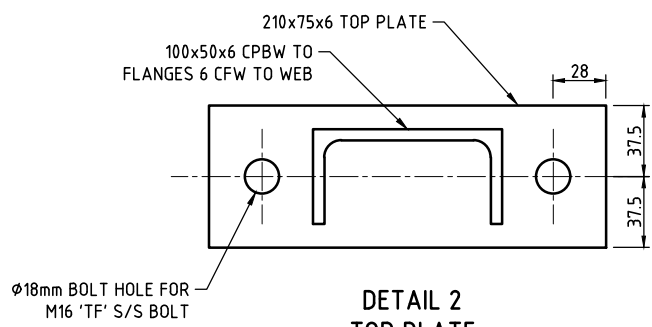

**DETAIL 2 TOP PLATE**  
SCALE 1:2

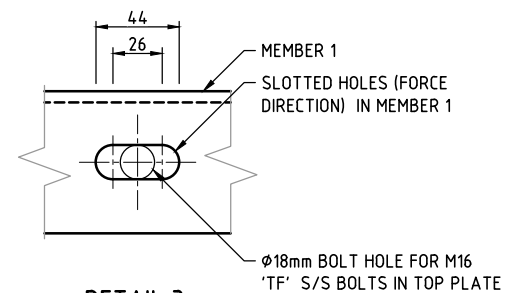


**DETAIL 3 SLOTTED HOLE**  
SCALE 1:2

MEMBER SCHEDULE		
MEMBER	SECTION	LENGTH (APPROX)
1	150x75x6 PFC	490mm
2	100x50x6 PFC	400mm
3	100x50x6 PFC	420mm

- NOTES**
- FOR GENERAL NOTES REFER TO DRG No. 30032680-GA-1121.
  - FOR REINFORCEMENT DETAILS REFER TO DRG No. 30032680-GA-1123.
  - ALL STRUCTURAL DETAILS REFER TO DRG No. 30032680-GA-1122.
  - ALL STRUCTURAL MEMBERS AND COMPONENTS SHALL BE STAINLESS STEEL.
  - CONTRACTOR/DESIGNER MAY CONSIDER AN ALTERNATIVE MEANS OF CONSTRUCTION/RESTRAINT IN THE REINSTATEMENT OF THE BTF WALL.

DRAWING FILE LOCATION / NAME V:\_Vault\Projects\3003\30032680\110_CADD\CAD\DWG\30032680-GA-1124.dwg		PLOT DATE 14 Dec 2021		TIME 11:21:17	
EXTERNAL REFERENCE FILES	REV 01	DATE 14/12/2021	AMENDMENT / REVISION DESCRIPTION ISSUED FOR CONCEPT	WVR No.	APPROVAL
X:\SMC_A1_X_30032680_BASE				BK	DRAFTER <i>D LOOKER</i>
					DRAFTING CHECK <i>C HAYWOOD</i>
					DESIGNER <i>C HAYWOOD</i>
					DESIGN CHECK <i>A MOORE</i>
					PROJECT MANAGER <i>P LARKIN</i>
					PROJECT DIRECTOR <i>M DUNCANSON</i>
SCALES AT A1 SIZE DRAWING			DESIGNER		
SCALE 1:2 0.2 0 .02 .04 .06 .08 0.1			SMC		
SCALE 1:5 0.05 0 0.10 0.20			Member of the Surbana Jurong Group © ABN 47 065 475 149		
SCALE 1:100 1 0 1 2 3 4 5			CLIENT		
			Banana SHIRE		
PROJECT TITLE			BILOELA STP BIOLOGICAL TRICKLING FILTER 3 - WALL BRACKETS STAINLESS STEEL BRACKET GENERAL ARRANGEMENT AND DETAILS		
SCALE AS NOTED	PHASE CONCEPT	PROJECT / DRAWING No. 30032680-GA-1124	REVISION		-

**APPENDIX C – PROVISIONAL INLET CHANNEL REPLACEMENT  
CONCEPT**

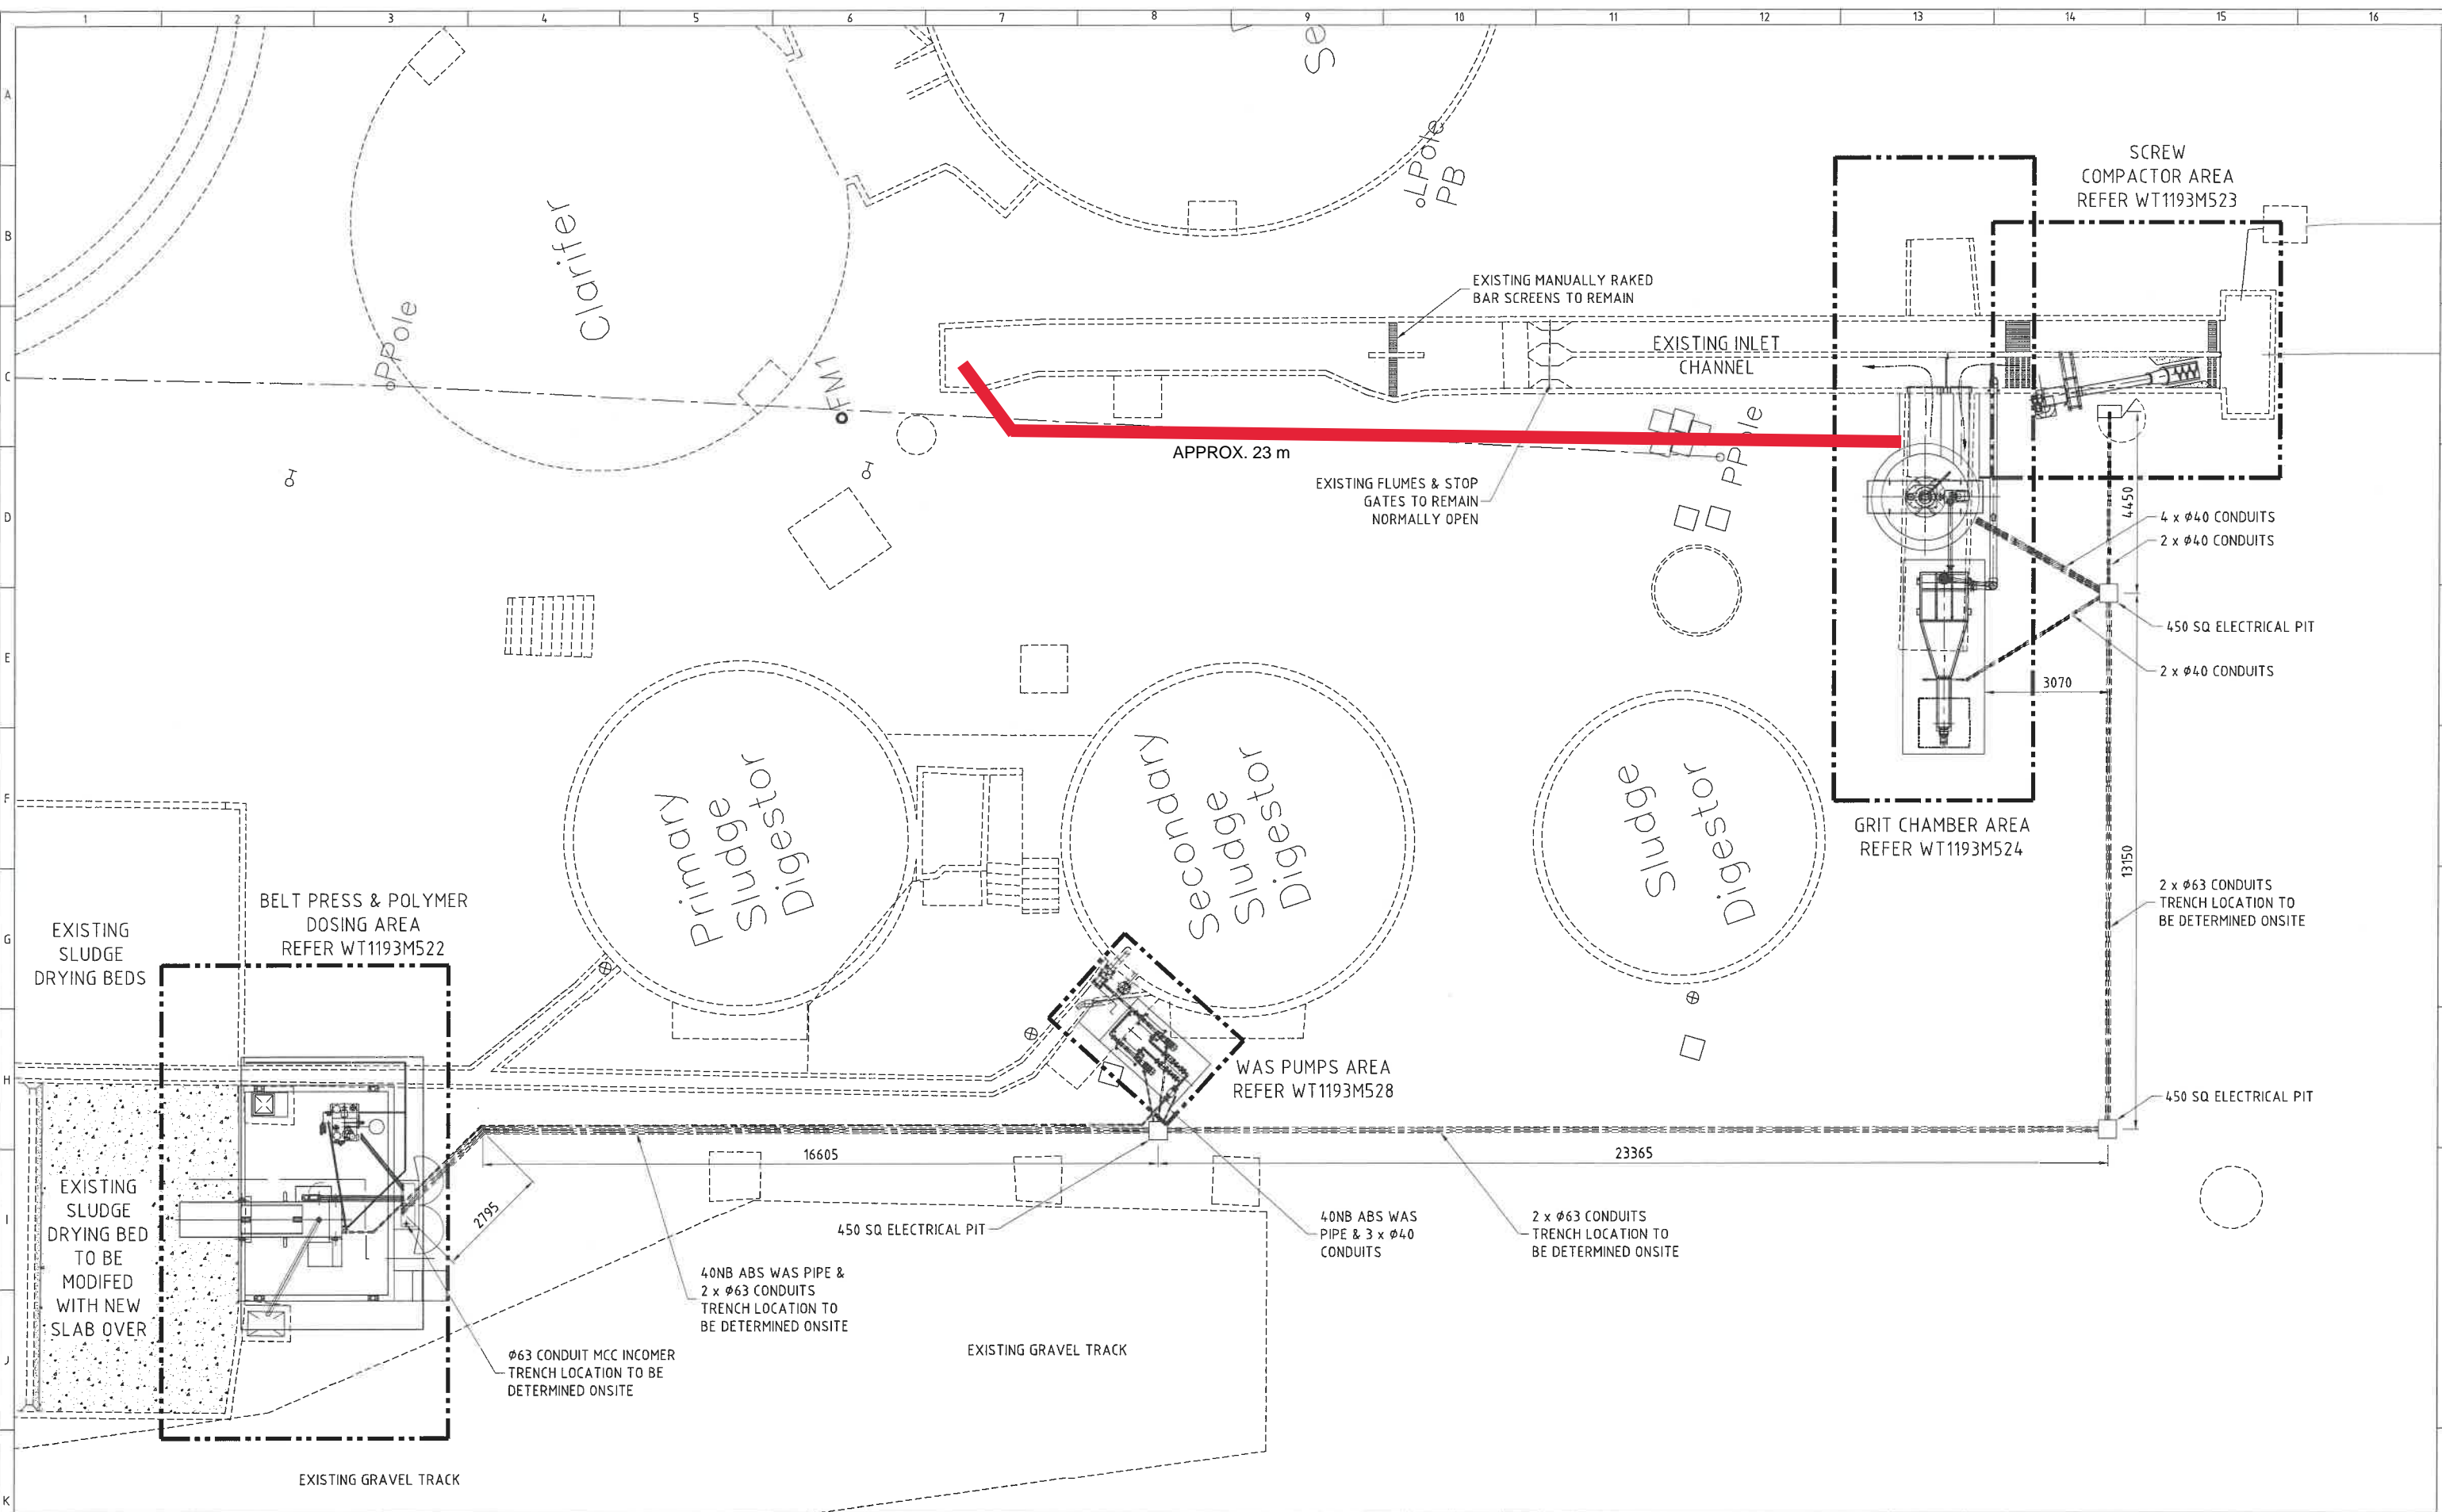

**NOTES**  
REFER PROJECT SPECIFICATION BEFORE COMMENCING ANY WORKS.

- 1. REFERENCE DRAWINGS**  
 WT1180M520 SITE PLAN  
 WT1180M522 BELT PRESS & POLYMER DOSING GENERAL ARRANGEMENT  
 WT1180M523 INLET WORKS SCREW COMPACTOR GENERAL ARRANGEMENT  
 WT1180M524 INLET WORKS GRIT CHAMBER GENERAL ARRANGEMENT  
 WT1180M528 WAS PUMPS GENERAL ARRANGEMENT

REV	DATE	AMENDMENT	REVISIONS
1	09/07/10	AS-BUILT	LCM
0	14/08/08	ISSUED FOR CONSTRUCTION	MTB DB IB
A	09/04/08	ISSUED FOR COMMENT	MTB DB IB

THIS DRAWING AND THE INFORMATION CONTAINED HEREIN ARE THE PROPERTY OF WATER TECHNOLOGY AUSTRALIA AND MUST NOT BE COPIED, REPRODUCED OR USED WITHOUT THE WRITTEN PERMISSION OF WATER TECHNOLOGY AUSTRALIA.

CLIENT: BANANA SHIRE COUNCIL

DESIGNED: IB 09/04/08  
 DRAWN: BNC 09/04/08  
 DRAWING CHECK: DB 09/04/08  
 DESIGN VERIFICATION:

**Water Technology Australia** 55 Lavinia Street Athol Park, SA 5012 Phone: (08) 8347 2970 Fax: (08) 8347 1811  
 A tyco COMPANY


BIOLOELA WASTEWATER TREATMENT PLANT

**SITE PLAN**

DATE: 09/04/08 SCALE: 1:75 SIZE: A1 DRAWING No.: WT1193 M520 REVISION: 1



## **APPENDIX D – EXISTING ASSET DRAWINGS**

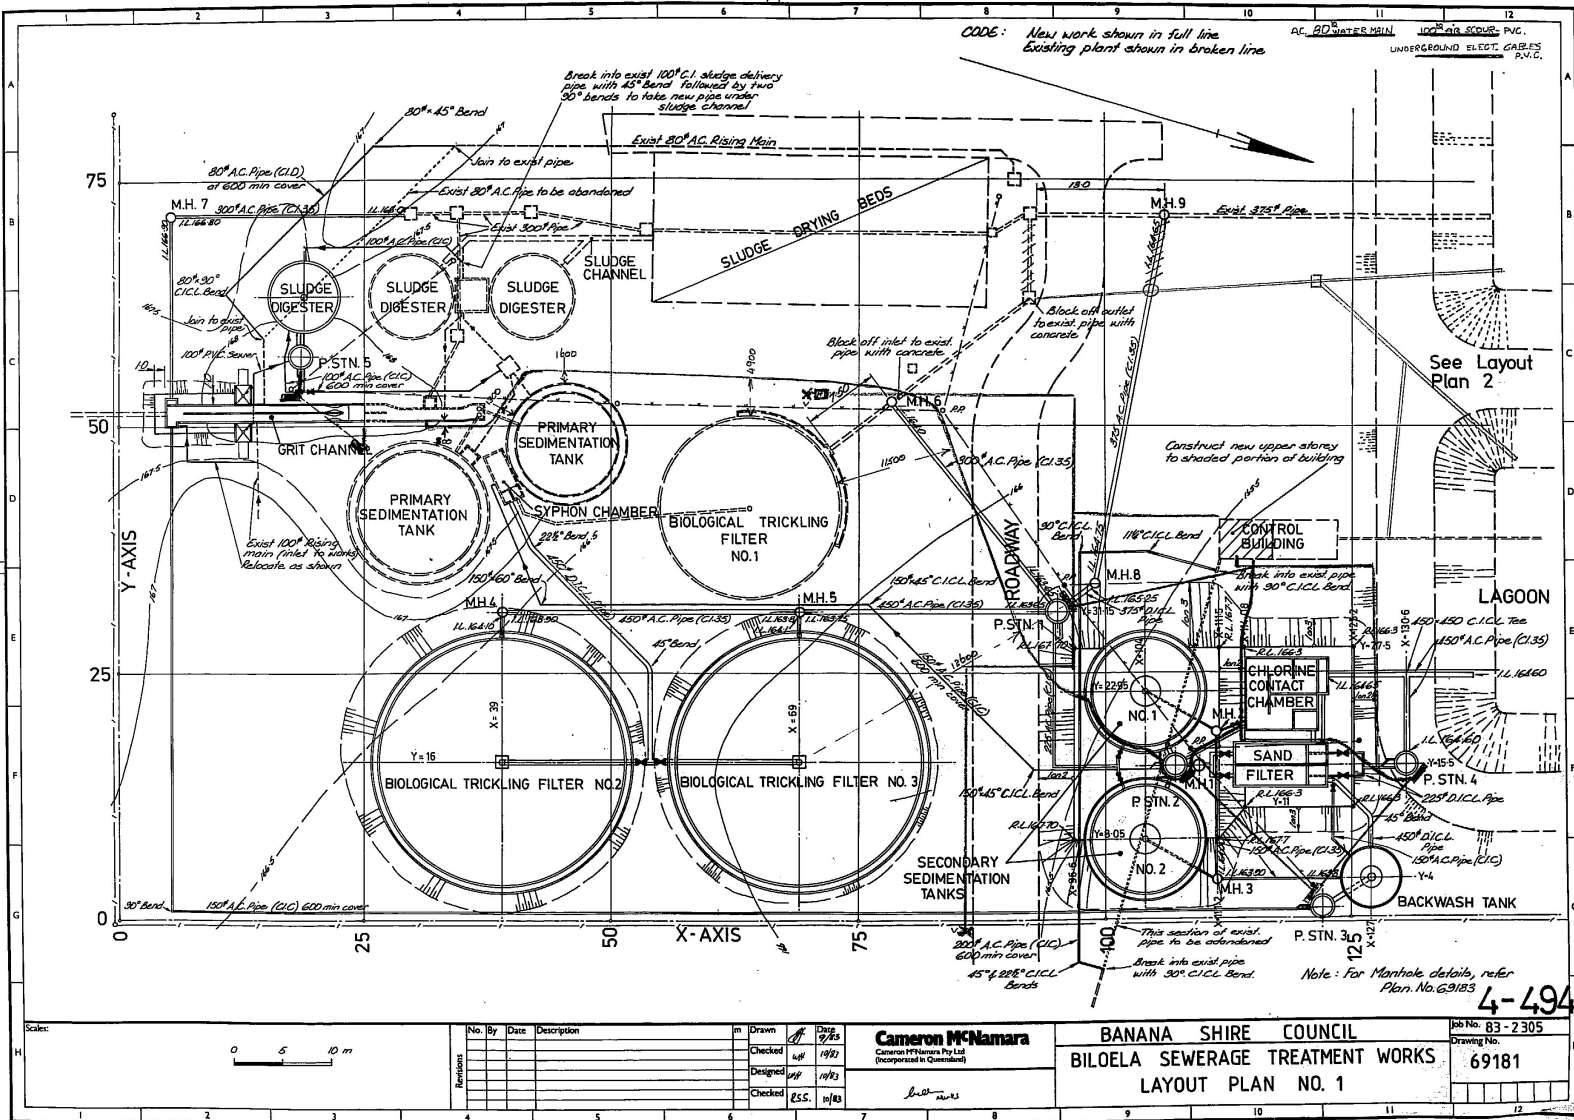

CODE: New work shown in full line  
Existing plant shown in broken line.


AC. 80 WATER MAIN 100 mm dia. S.C. PVC.  
UNDERGROUND ELECT. CABLES P.V.C.

See Layout Plan 2

Construct new upper storey to shaded portion of building

Note: For Manhole details, refer Plan No. 63183

4-494

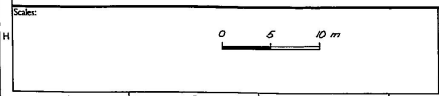


No.	By	Date	Description	m	Drawn	Checked	Date


**Cameron McNamara**  
Cameron McNamara Pty Ltd  
(Incorporated in Queensland)

**BANANA SHIRE COUNCIL**  
**BIOLOELA SEWERAGE TREATMENT WORKS**  
**LAYOUT PLAN NO. 1**

Job No. 83-2305  
Drawing No. 69181

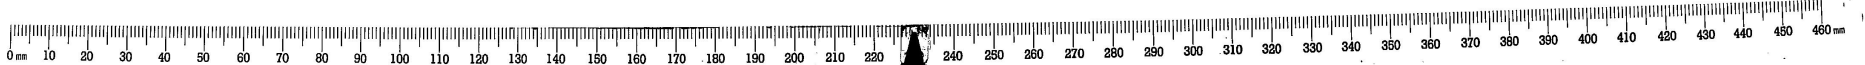



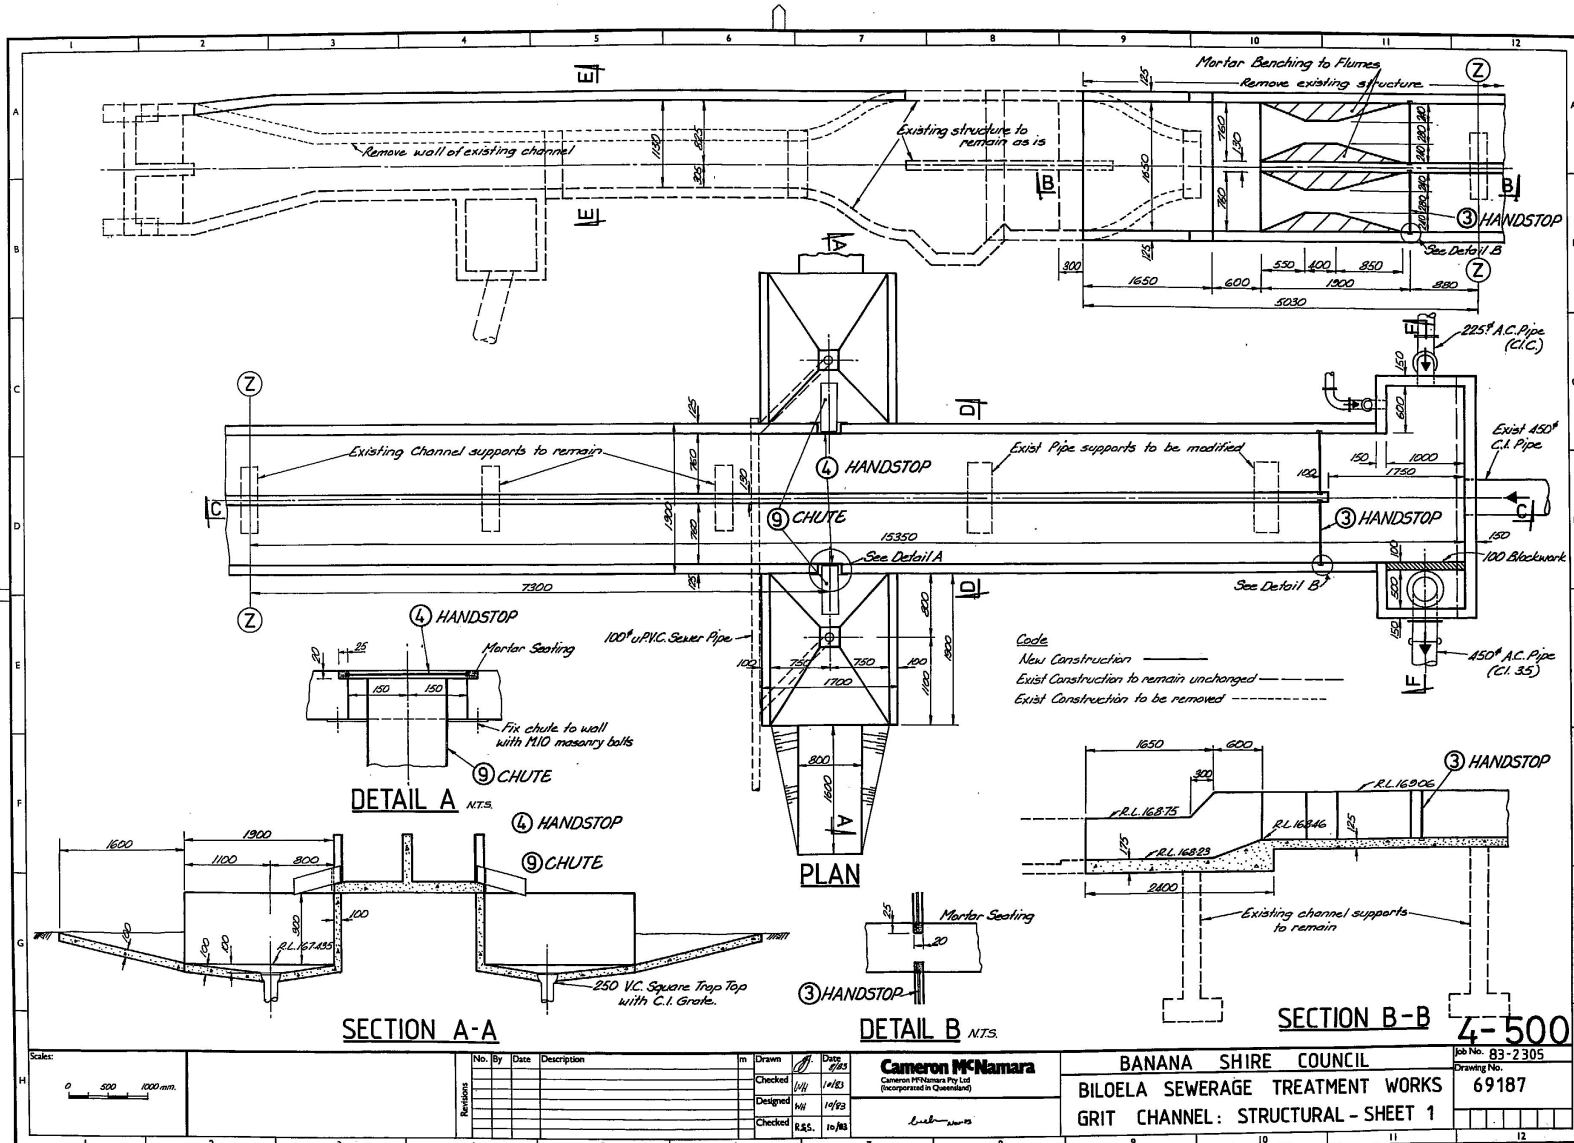

Scale:  
 0 500 1000mm


No.	By	Date	Description

**Cameron McNamara**  
 Cameron McNamara Pty Ltd  
 (Incorporated in Queensland)

**BANANA SHIRE COUNCIL**  
**BILOELA SEWERAGE TREATMENT WORKS**  
**GRIT CHANNEL: STRUCTURAL - SHEET 1**

Job No. 83-2305  
 Drawing No. 69187



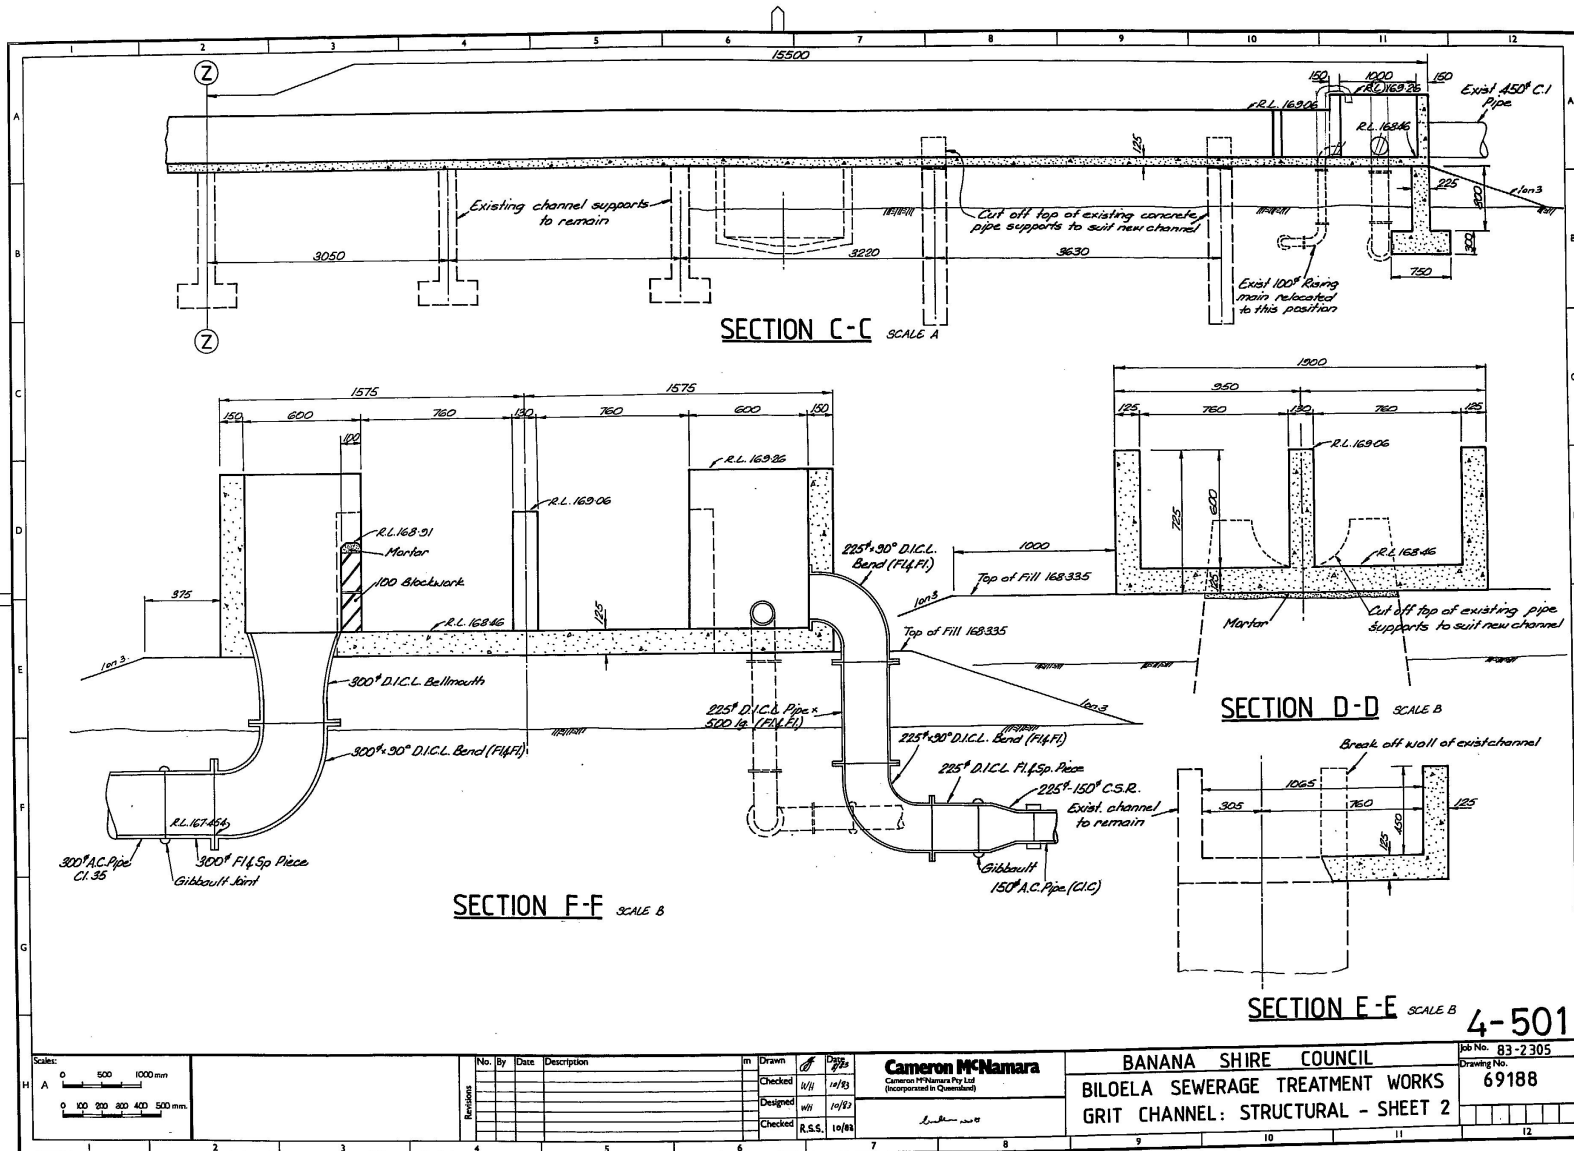


SECTION C-C SCALE A

SECTION D-D SCALE B

SECTION F-F SCALE B

SECTION E-E SCALE B

4-501

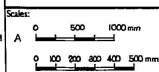



No.	By	Date	Description	m	Drawn	Disc
					Checked	14/93
					Designed	14/93
					Checked	R.S.S. 10/98

**Cameron McNamara**  
 Cameron McNamara Pty Ltd  
 (Incorporated in Queensland)

**BANANA SHIRE COUNCIL**  
**BILOELA SEWERAGE TREATMENT WORKS**  
**GRIT CHANNEL: STRUCTURAL - SHEET 2**

Job No: 63-2305  
 Drawing No: 69188

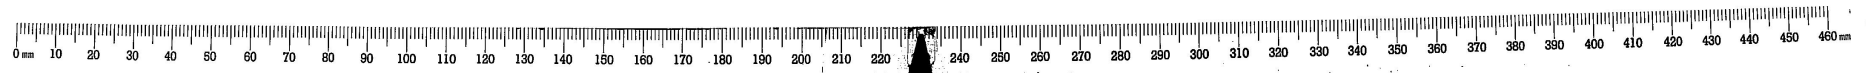

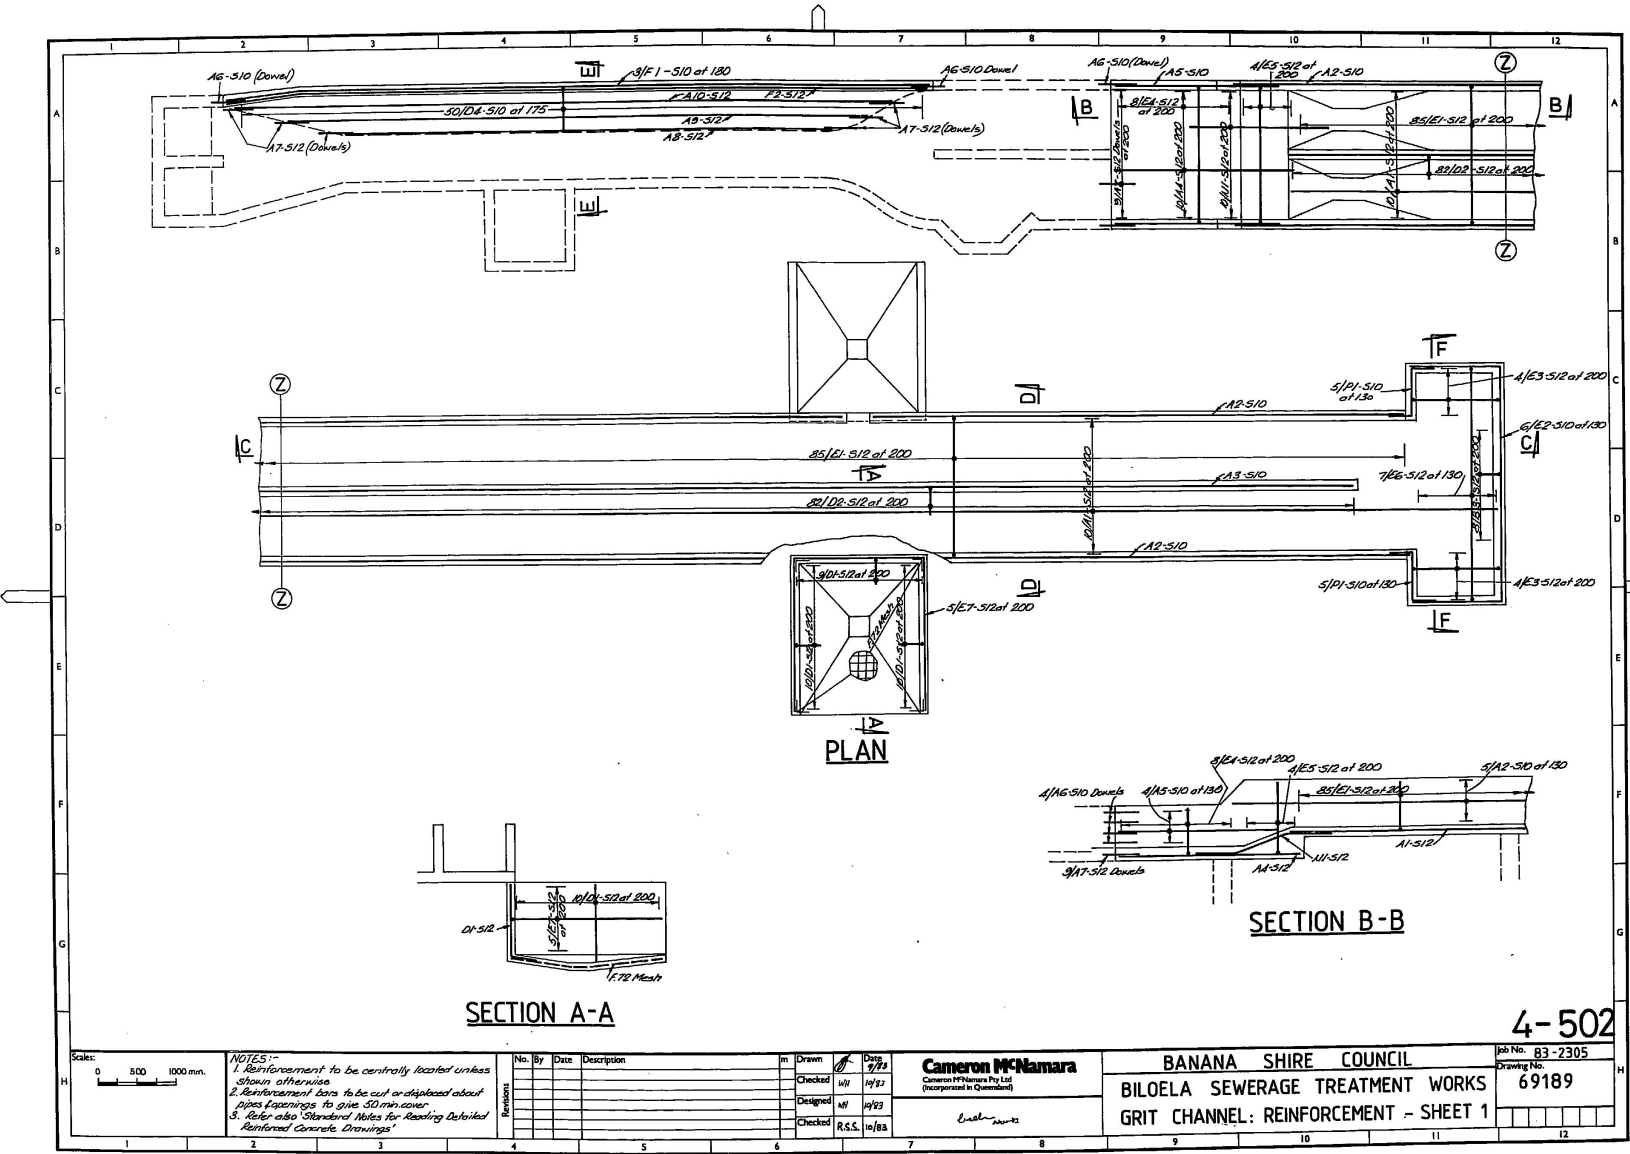

Scales:  
 0 500 1000 mm.

NOTES:-  
 1. Reinforcement to be centrally located unless shown otherwise.  
 2. Reinforcement bars to be cut or displaced about pipes openings to give 50 mm cover.  
 3. Refer also Standard Notes for Reading Detailed Reinforced Concrete Drawings.


No.	By	Date	Description


Drawn	Date

**Cameron McNamara**  
 Cameron McNamara Pty Ltd  
 (Incorporated in Queensland)  
 Date: 12/03

**BANANA SHIRE COUNCIL**  
**BILOELA SEWERAGE TREATMENT WORKS**  
**GRIT CHANNEL: REINFORCEMENT - SHEET 1**

Job No. 83-2305  
 Drawing No. 69189

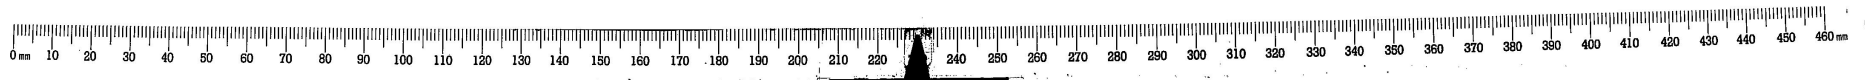

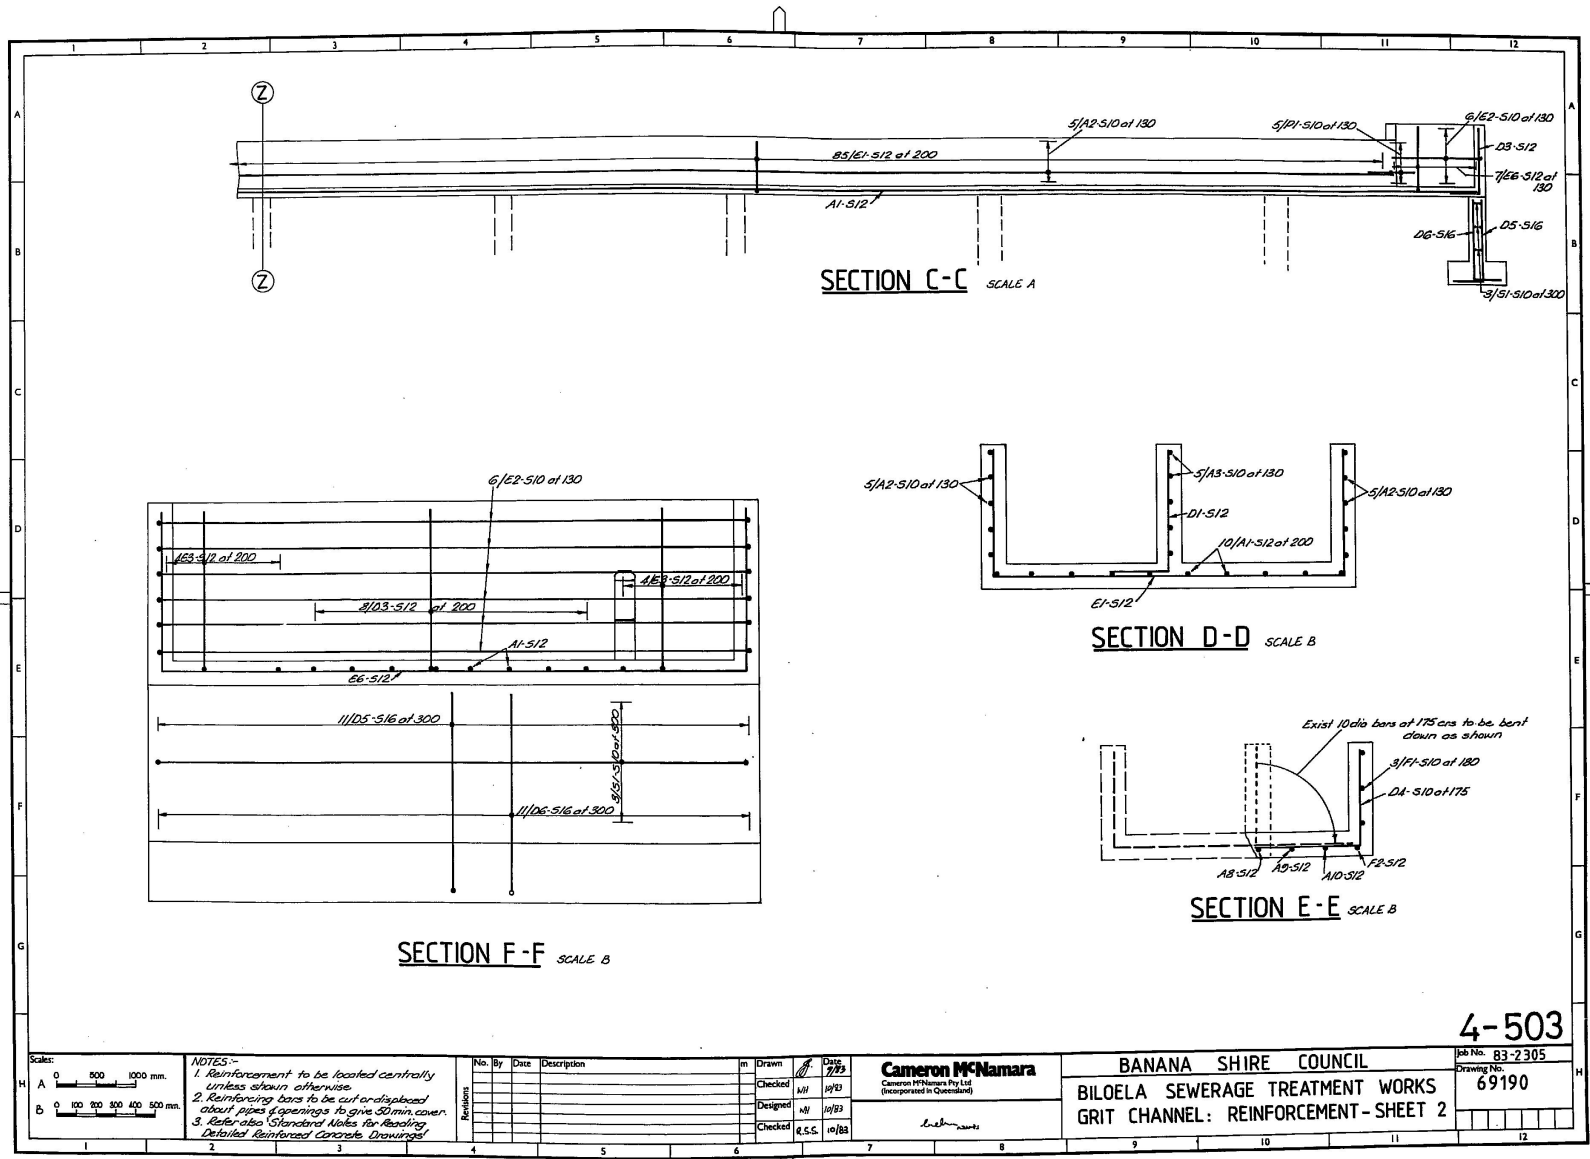


**SECTION C-C** SCALE A

**SECTION D-D** SCALE B

**SECTION E-E** SCALE B

**SECTION F-F** SCALE B

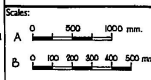


- NOTES:-**
1. Reinforcement to be located centrally unless shown otherwise.
  2. Reinforcing bars to be cut and placed about pipes & openings to give 50mm cover.
  3. Refer also Standard Notes for Reading Detailed Reinforced Concrete Drawings.


No.	By	Date	Description	in	Drawn	Date
				Checked	MH	10/02
				Designed	MH	10/03
				Checked	G.S.S.	10/03

**Cameron McNamara**  
 Cameron McNamara Pty Ltd  
 (Incorporated in Queensland)

**BANANA SHIRE COUNCIL**  
**BILOELA SEWERAGE TREATMENT WORKS**  
**GRIT CHANNEL: REINFORCEMENT - SHEET 2**

**4-503**  
 Job No. 83-2305  
 Drawing No. 69190

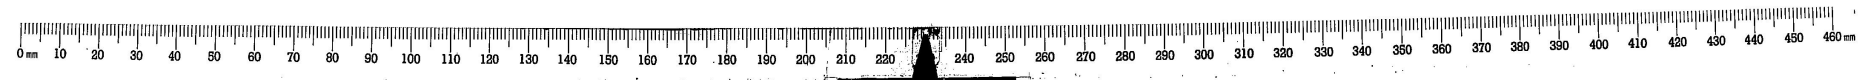

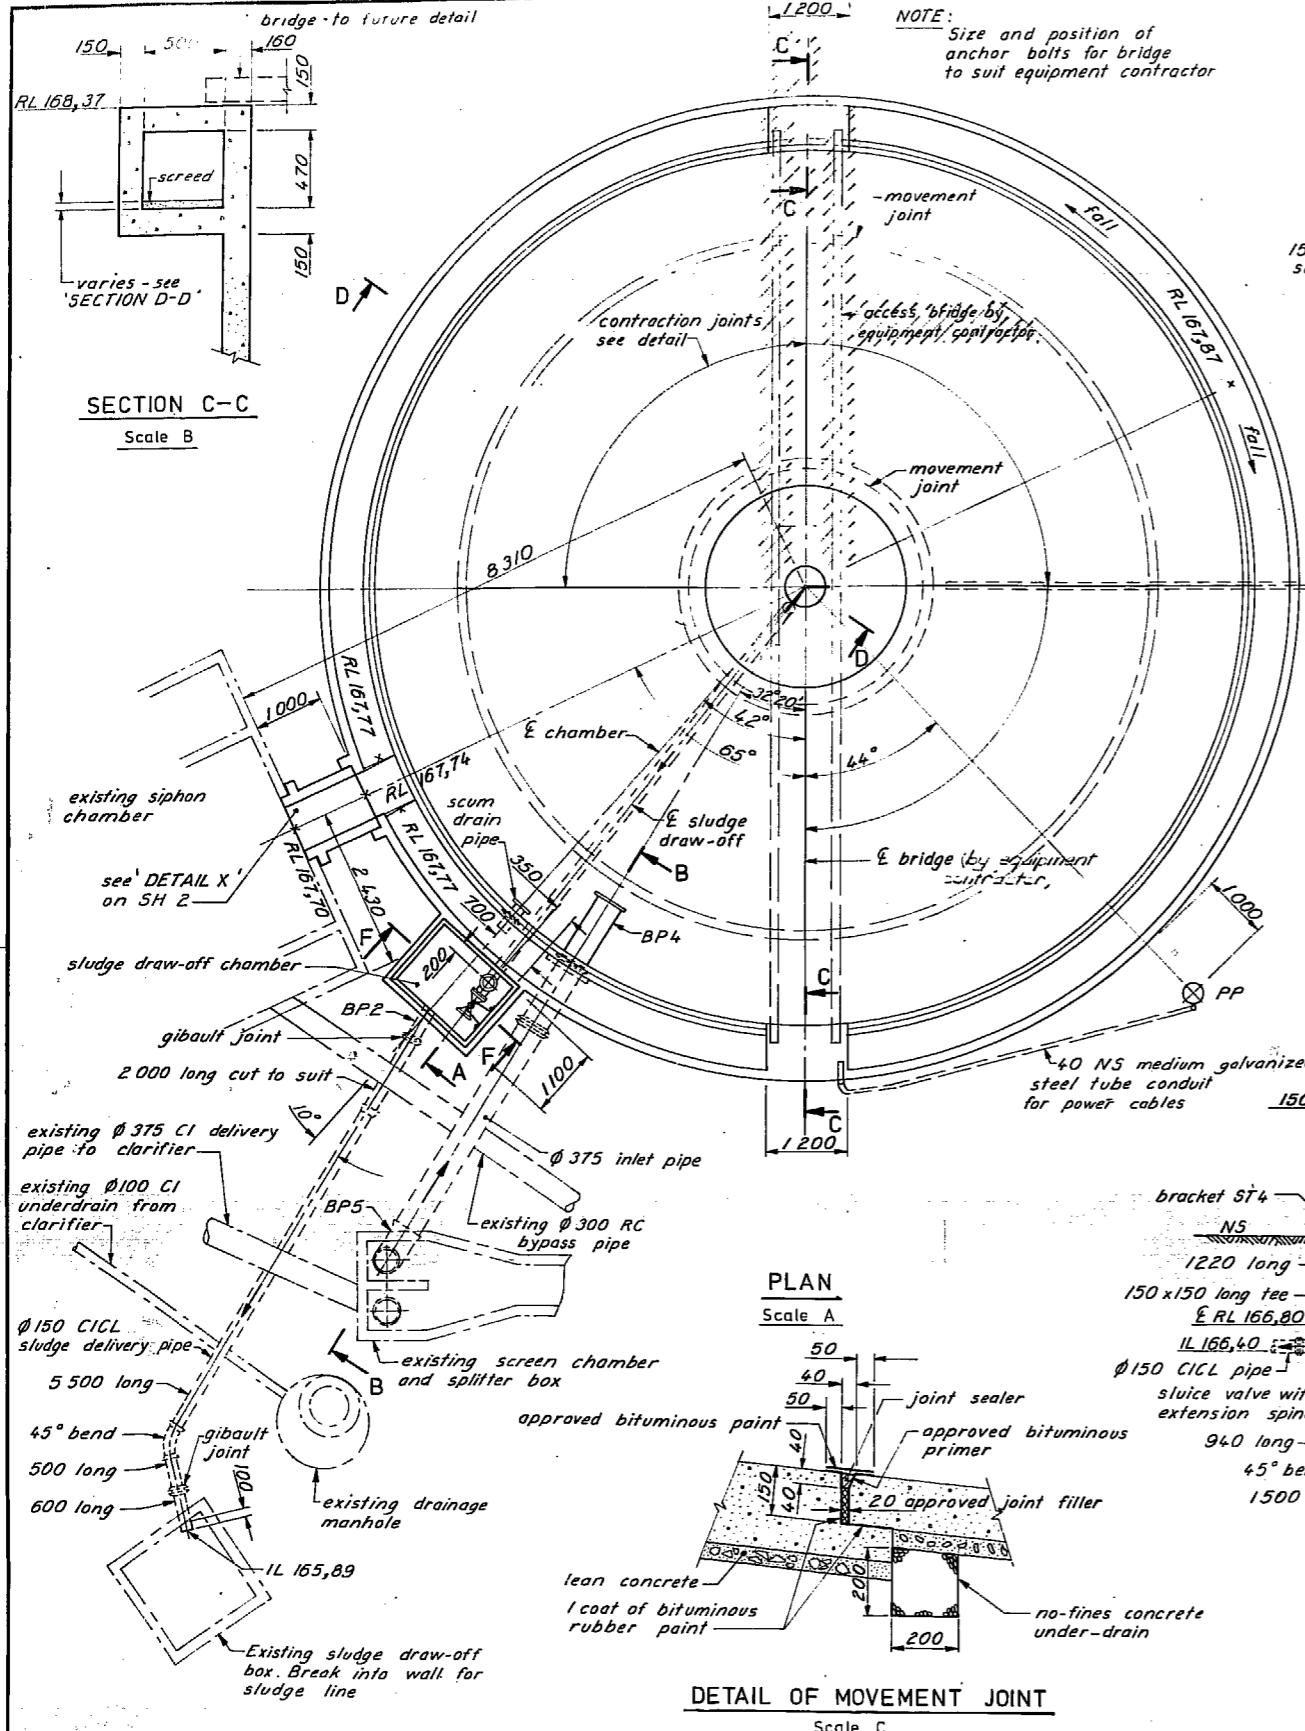

**SECTION C-C**  
Scale B

**REFERENCE TO DRAWINGS**


78062-3	Layout Plan SH 1 & 2
78069	Structural SH 2
78070-1	Reinforcement SH 1 & 2
78077-6	Steelwork SH 1 & 2

**NOTES**


All CI pipes and fittings to AS 1488 and AS 1723 Class C short with heavy cement lining unless otherwise shown.

**SCALES**


A	0	1	2	3	4	m
B	0	400	800	1200	1600	mm
C	0	200	400	600	800	mm

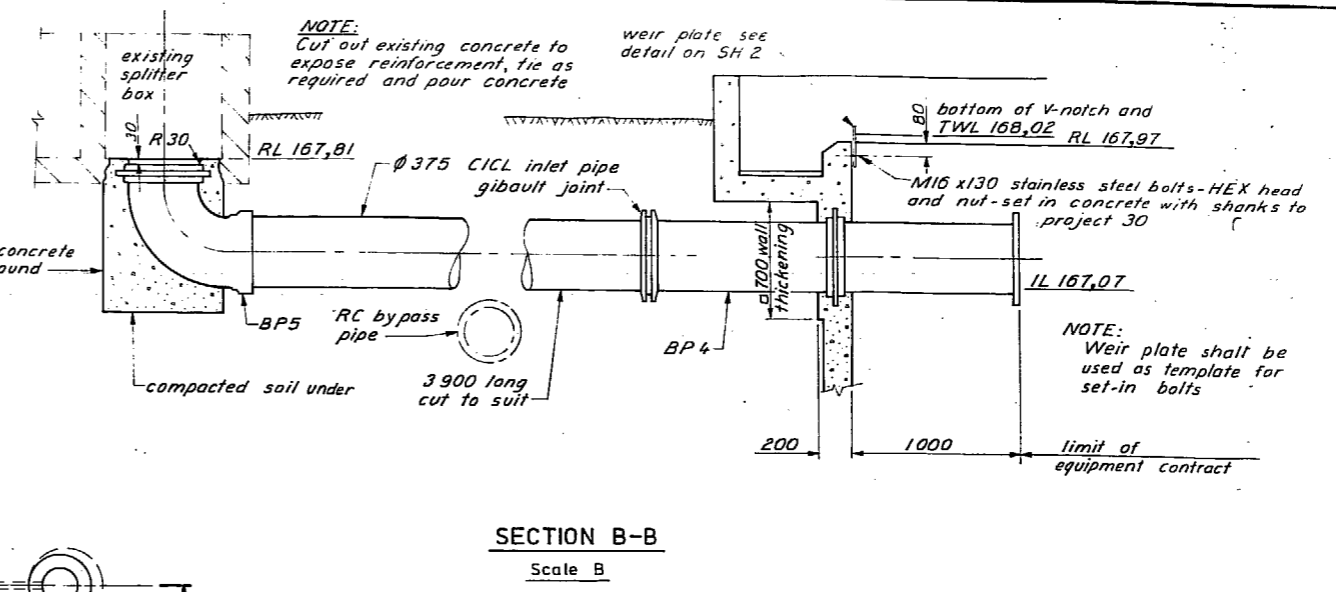


**SECTION B-B**  
Scale B

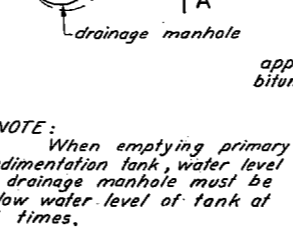

**DETAIL OF CONTRACTION JOINT**  
Scale C

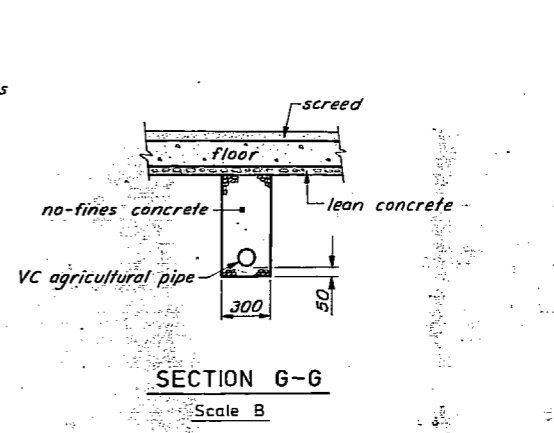

**SECTION G-G**  
Scale B

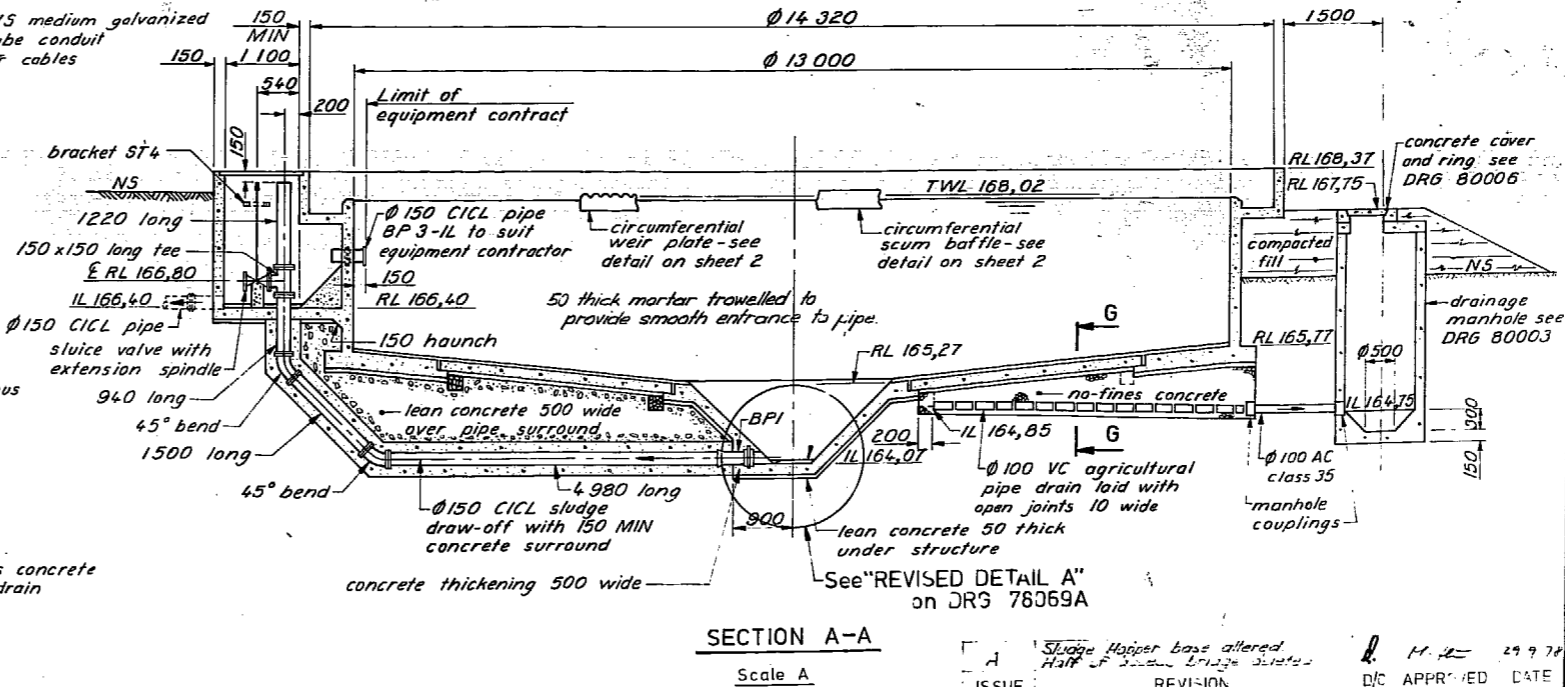

**SECTION A-A**  
Scale A


Sludge Hopper base altered  
Half of bottom bridge altered

ISSUE	REVISION	D/C	APPROVED	DATE
				29.9.78

<p>DEPARTMENT OF LOCAL GOVERNMENT TOWN WATER SUPPLY AND SEWERAGE BRANCH BANANA SHIRE COUNCIL—BILOELA SEWERAGE</p>		<p>JOB NO S 150</p>
<p><b>TREATMENT PLANT AUGMENTATION</b></p>		<p>4-381</p>
<p>PRIMARY SEDIMENTATION TANK—STRUCTURAL—SH 1</p>		<p>A</p>





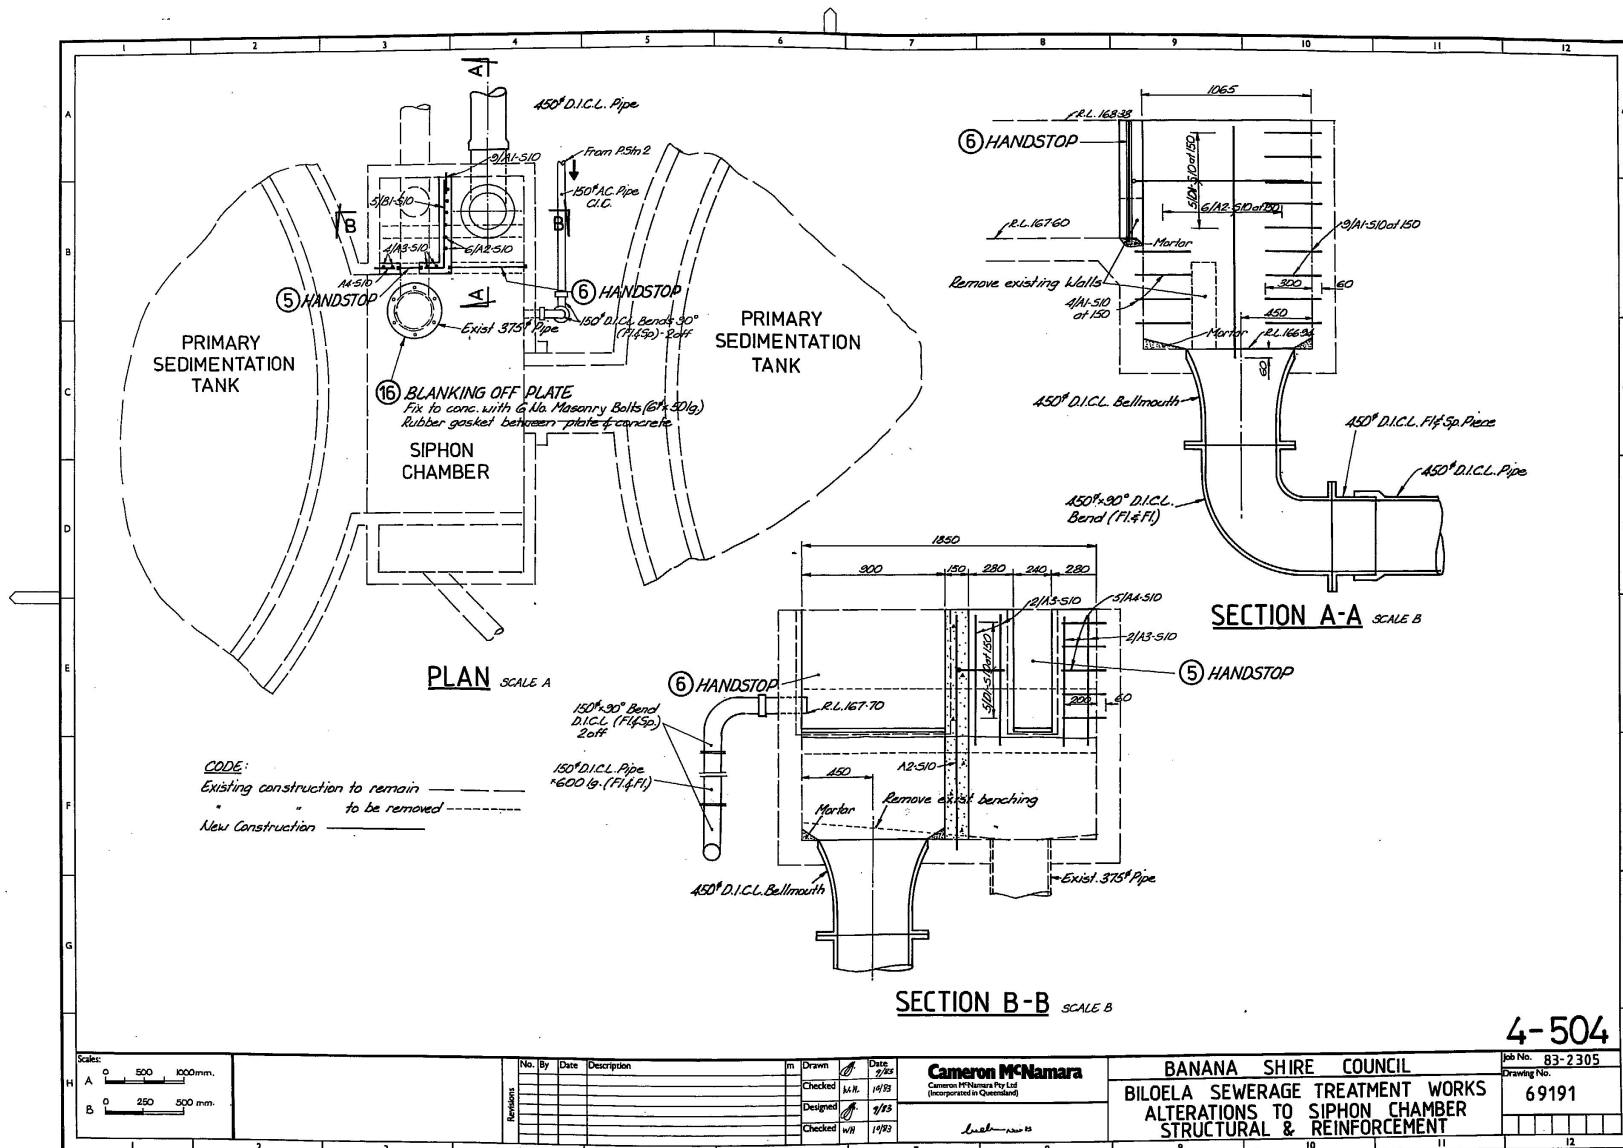


4-504

Job No. 83-2305  
 Drawing No. 69191


**Cameron McNamara**  
 Cameron McNamara Pty Ltd  
 (Incorporated in Queensland)

**BANANA SHIRE COUNCIL**  
**BILOELA SEWERAGE TREATMENT WORKS**  
**ALTERATIONS TO SIPHON CHAMBER**  
**STRUCTURAL & REINFORCEMENT**




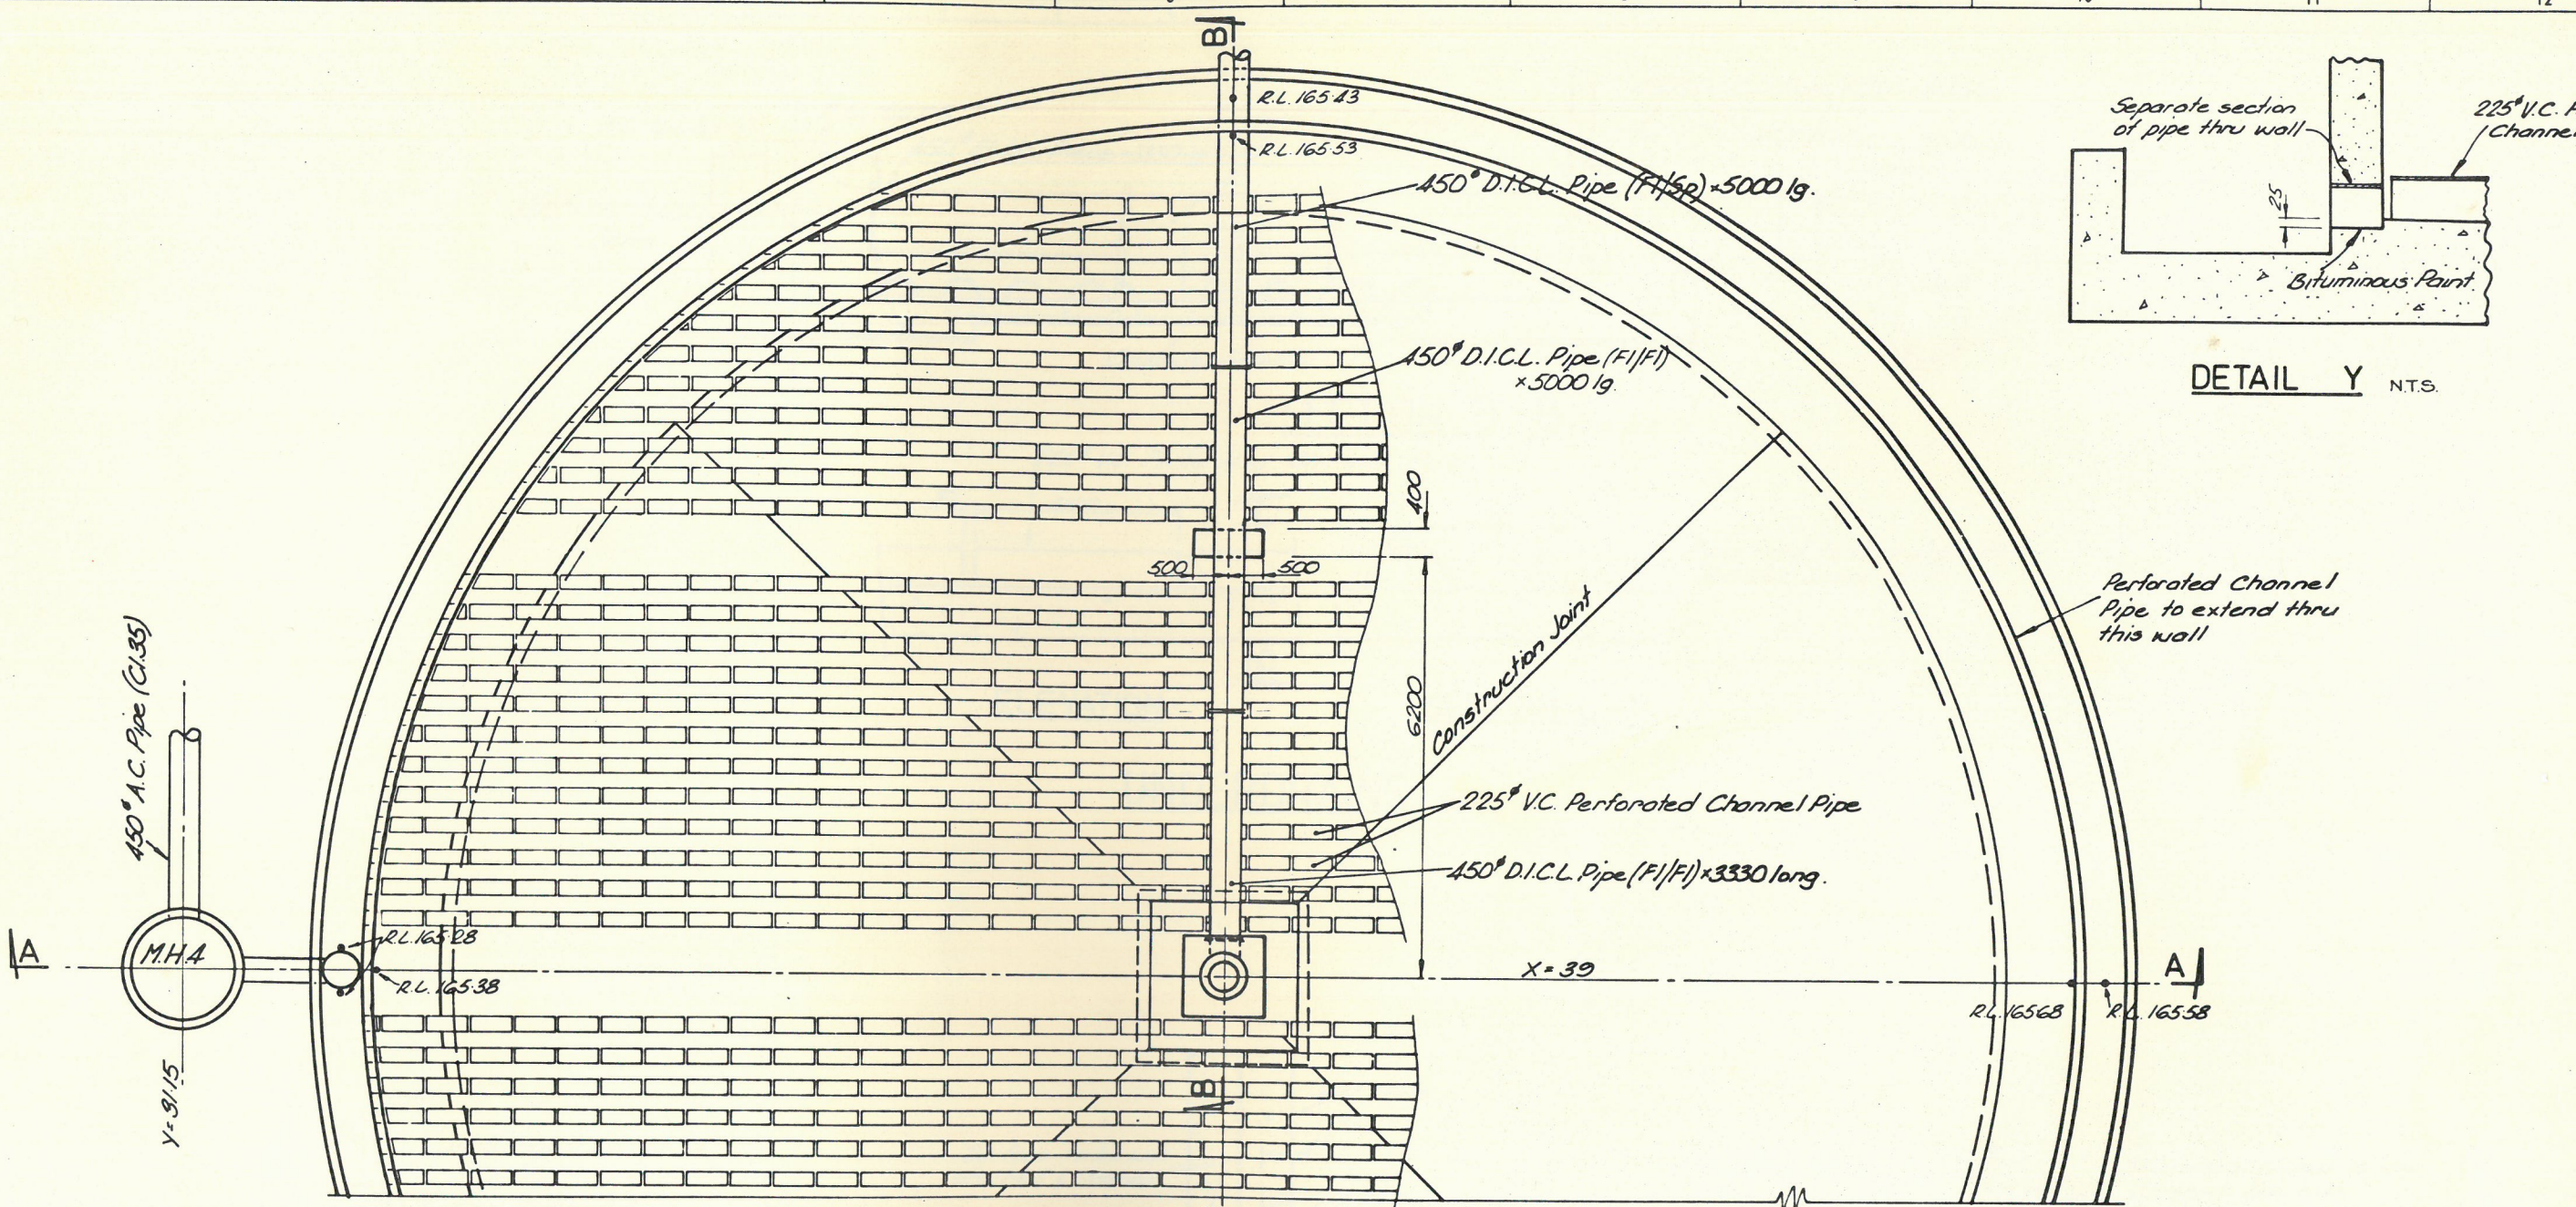

PLAN

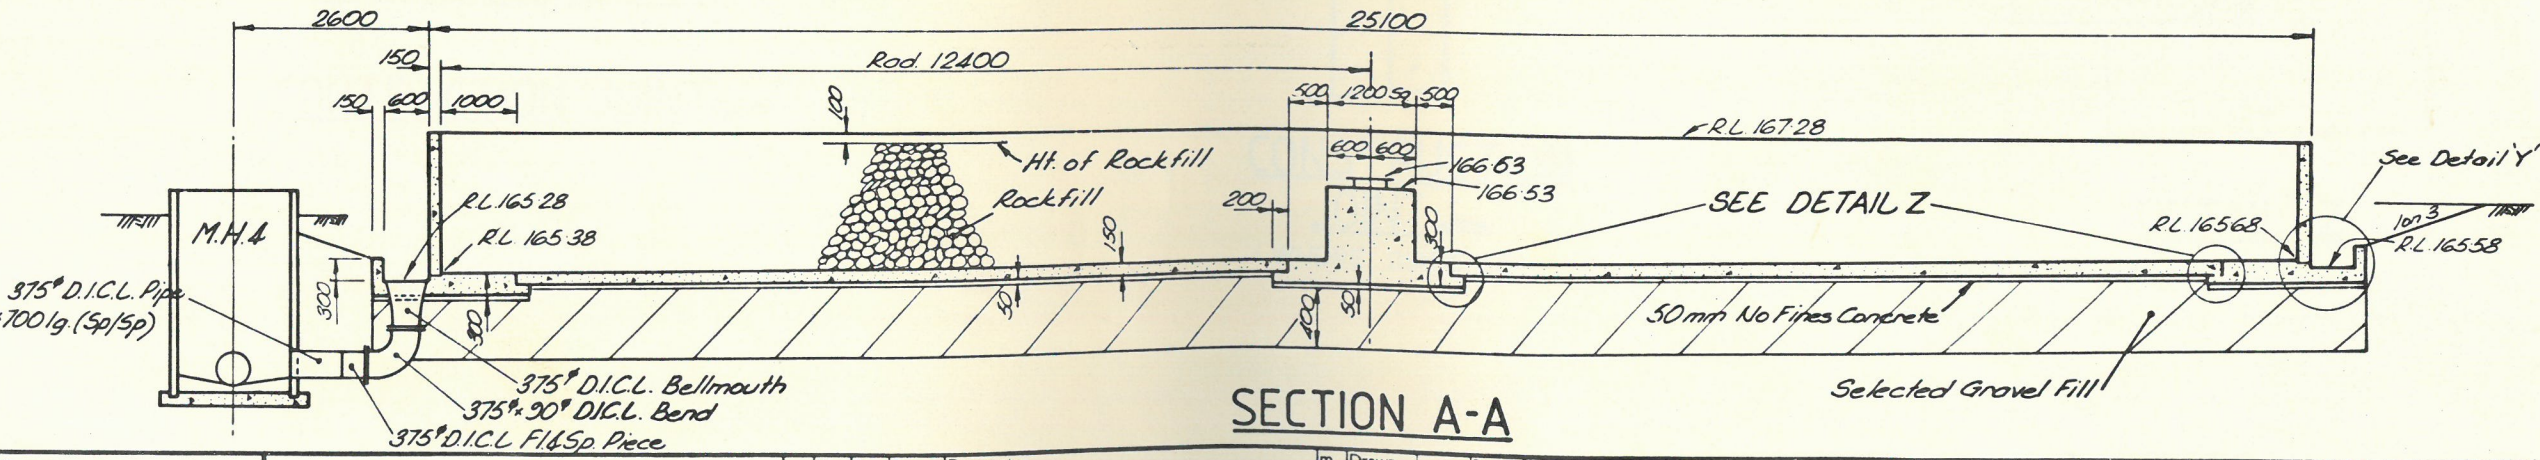

SECTION A-A

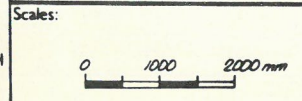

No.	By	Date	Description
A	JG	3/84	Detail Y added


m	Drawn	Date
	W/R	10/83
	W/R	10/83
	R.S.S.	10/83

**Cameron McNamara**  
Cameron McNamara Pty Ltd  
(Incorporated in Queensland)


**BANANA SHIRE COUNCIL**  
**BILOELA SEWERAGE TREATMENT WORKS**  
**BIOLOGICAL TRICKLING FILTER**  
**STRUCTURAL - SHEET 1**

Job No. 83-2305  
Drawing No. 69192  
A

4 - 505

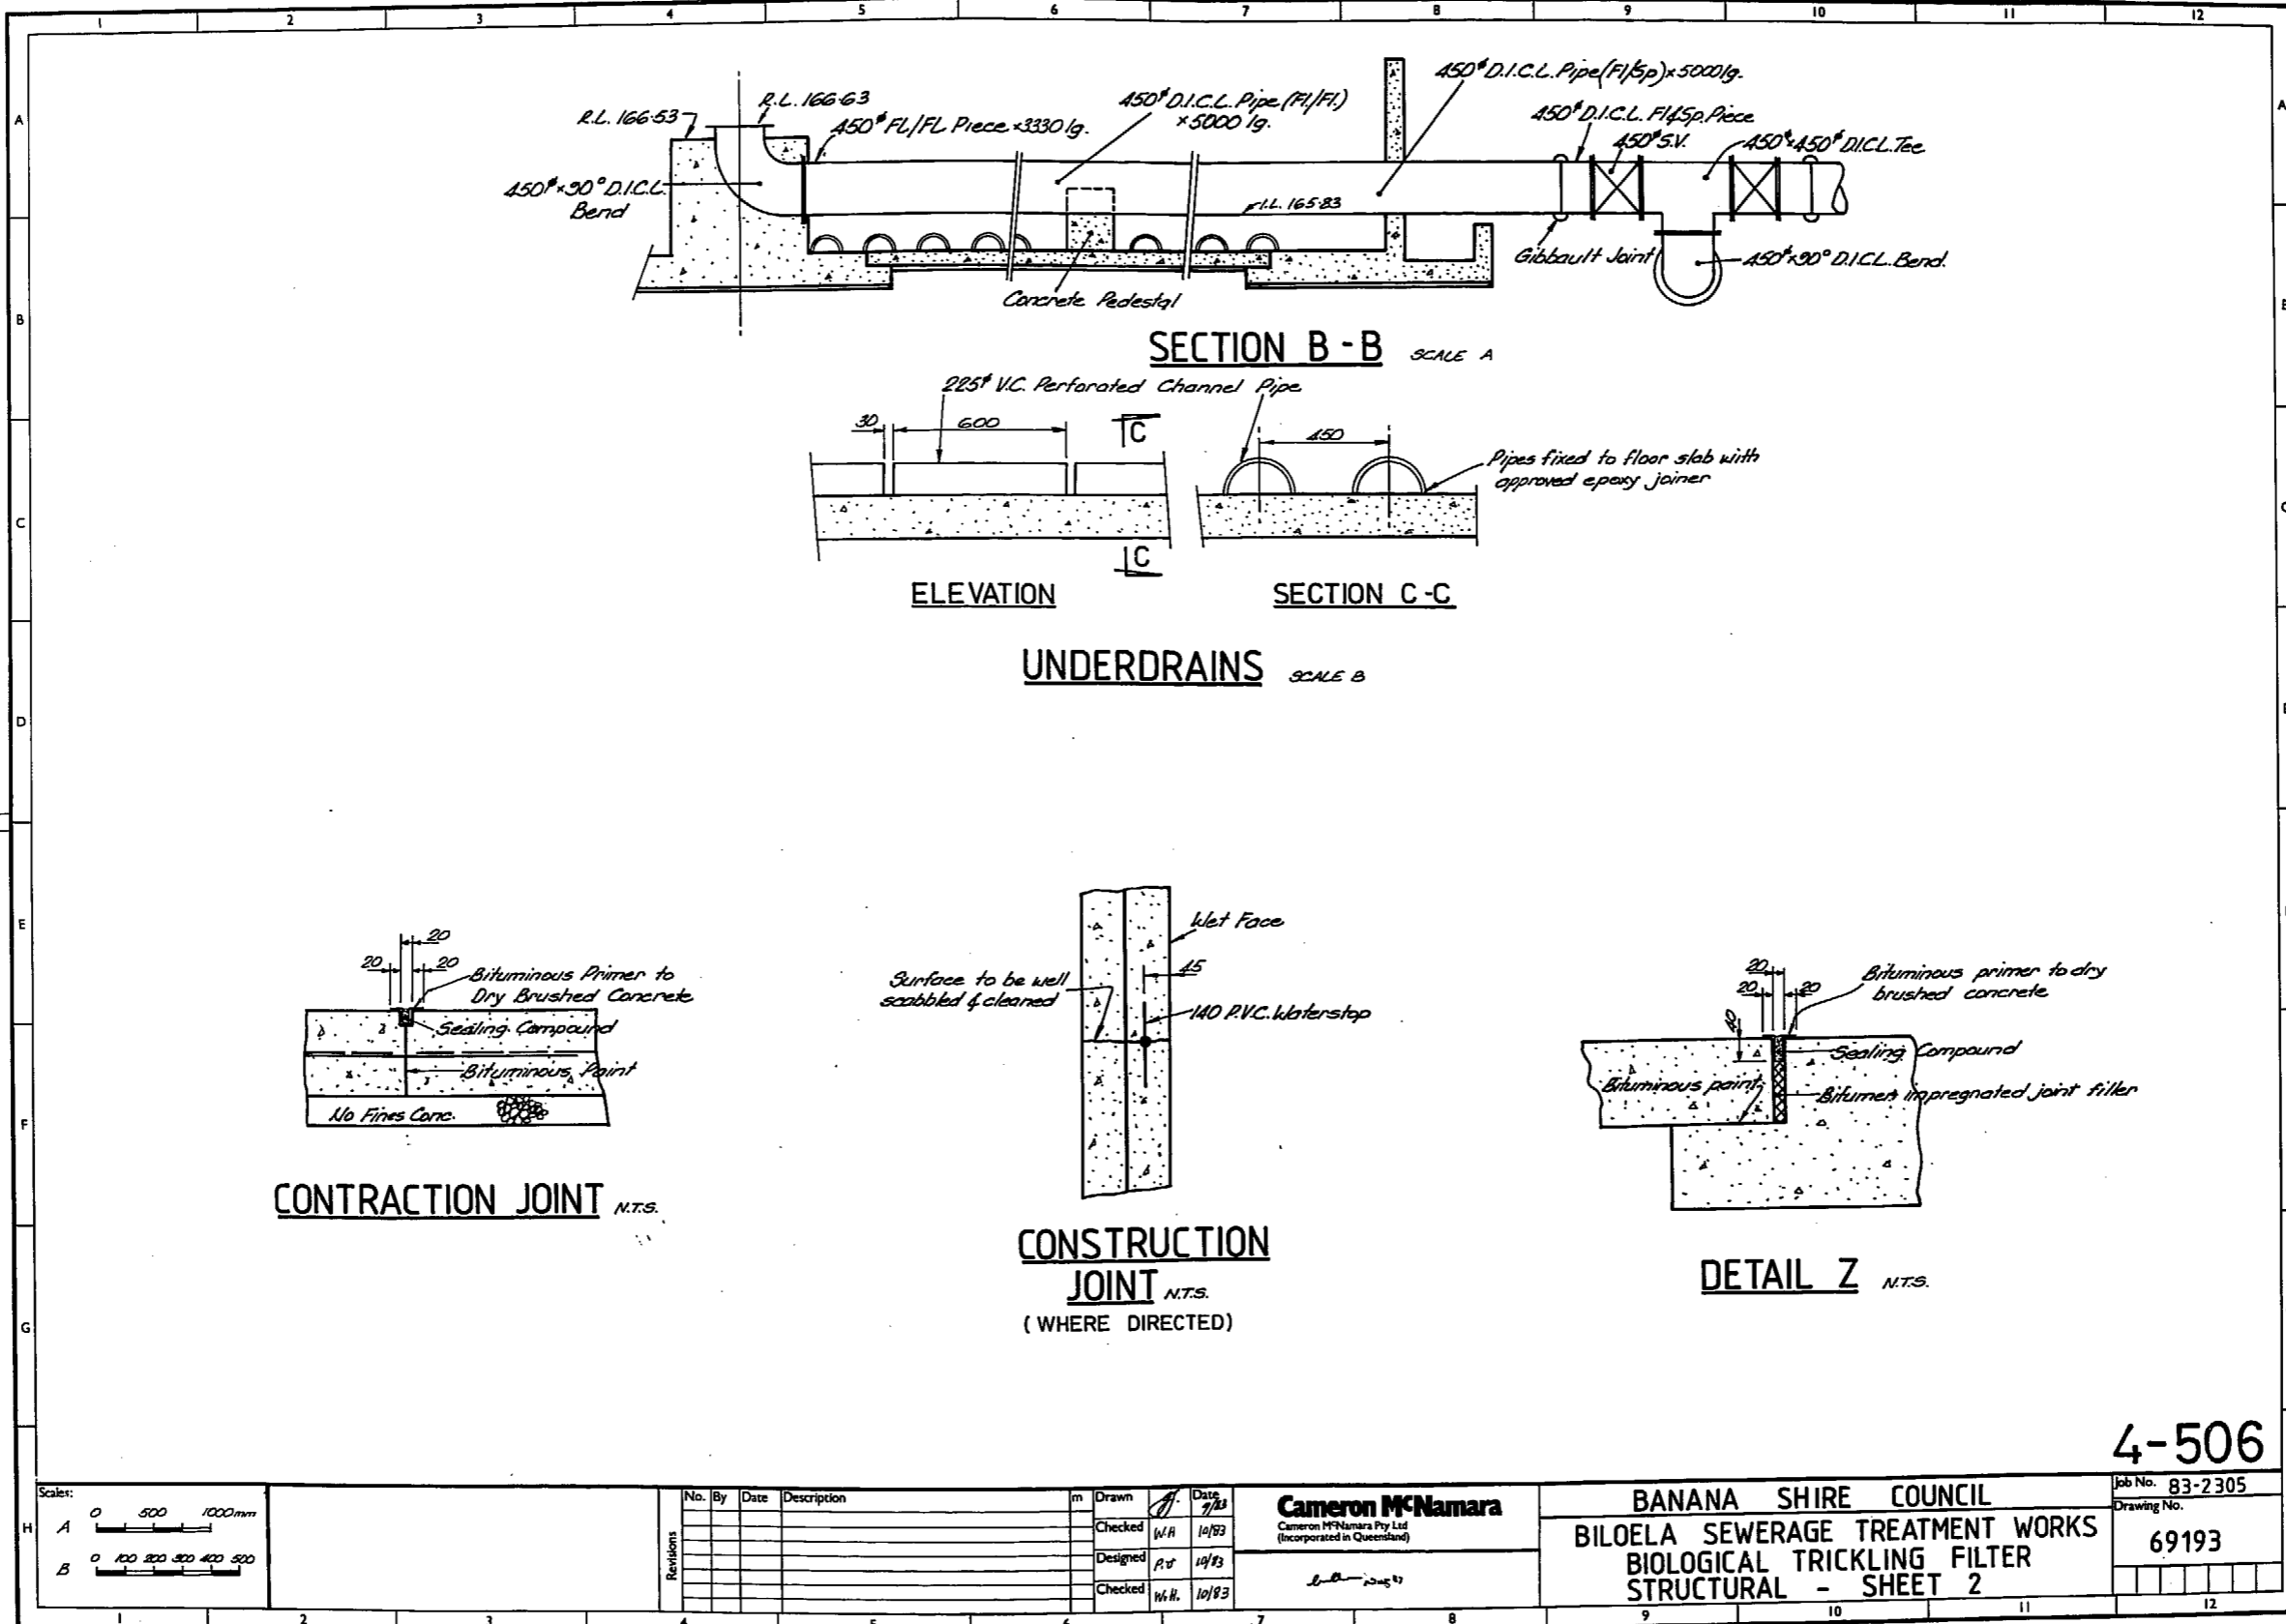

4-506

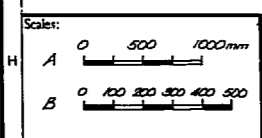




No.	By	Date	Description	m	Drawn	Date

**Cameron McNamara**  
Cameron McNamara Pty Ltd  
(Incorporated in Queensland)


**BANANA SHIRE COUNCIL**  
**BILOELA SEWERAGE TREATMENT WORKS**  
**BIOLOGICAL TRICKLING FILTER**  
**STRUCTURAL - SHEET 2**

Job No. 83-2305  
Drawing No. 69193

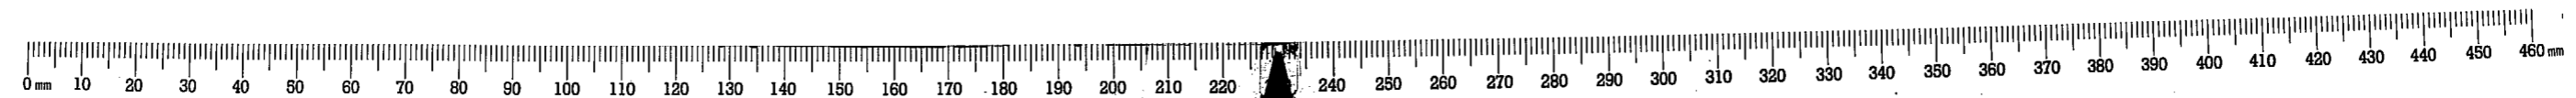


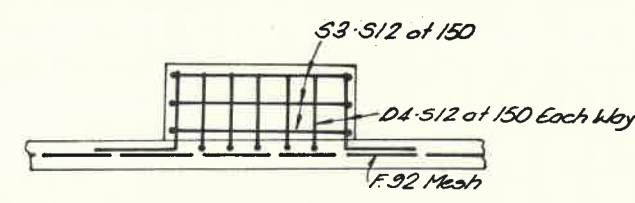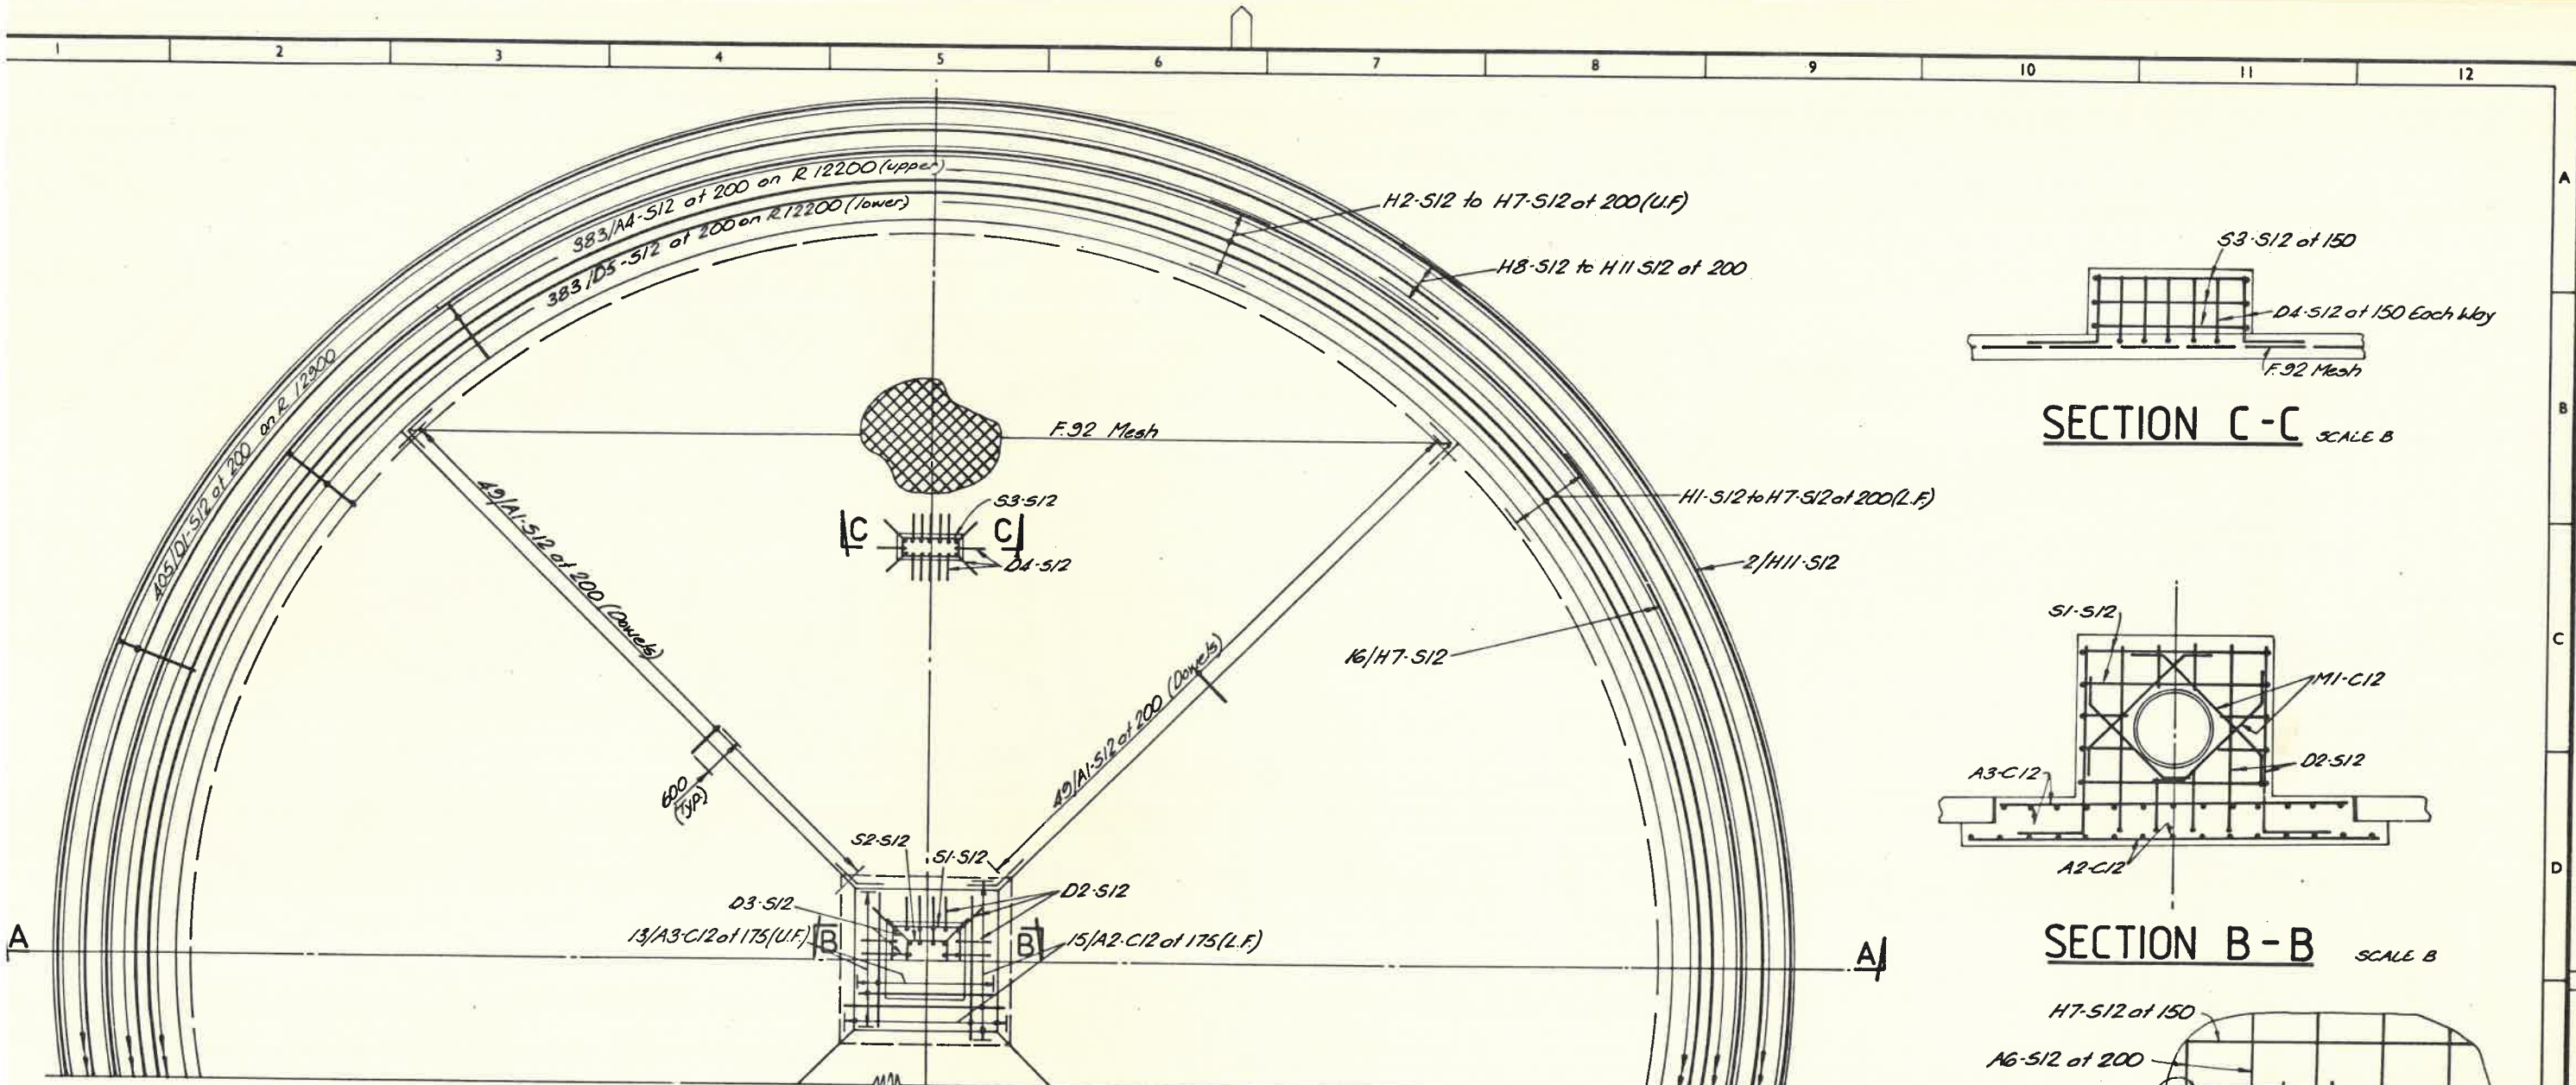


SECTION C-C SCALE B

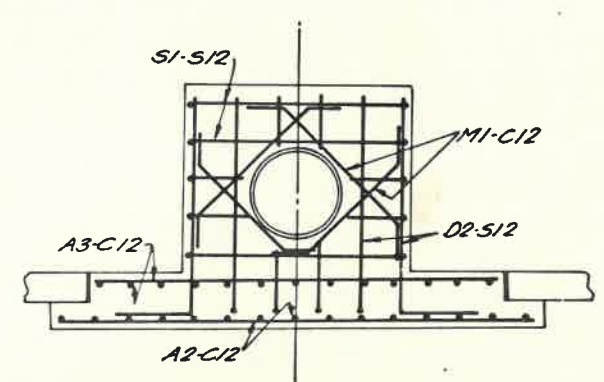


SECTION B-B SCALE B

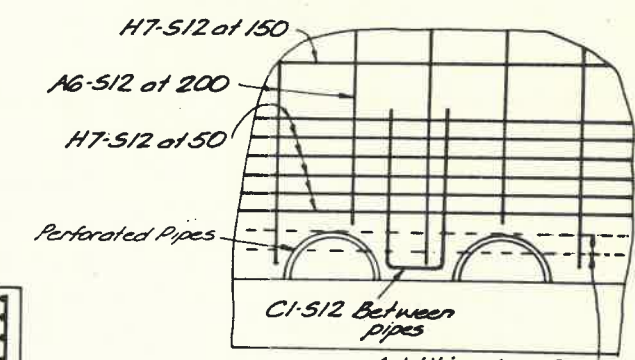

DETAIL X N.T.S.

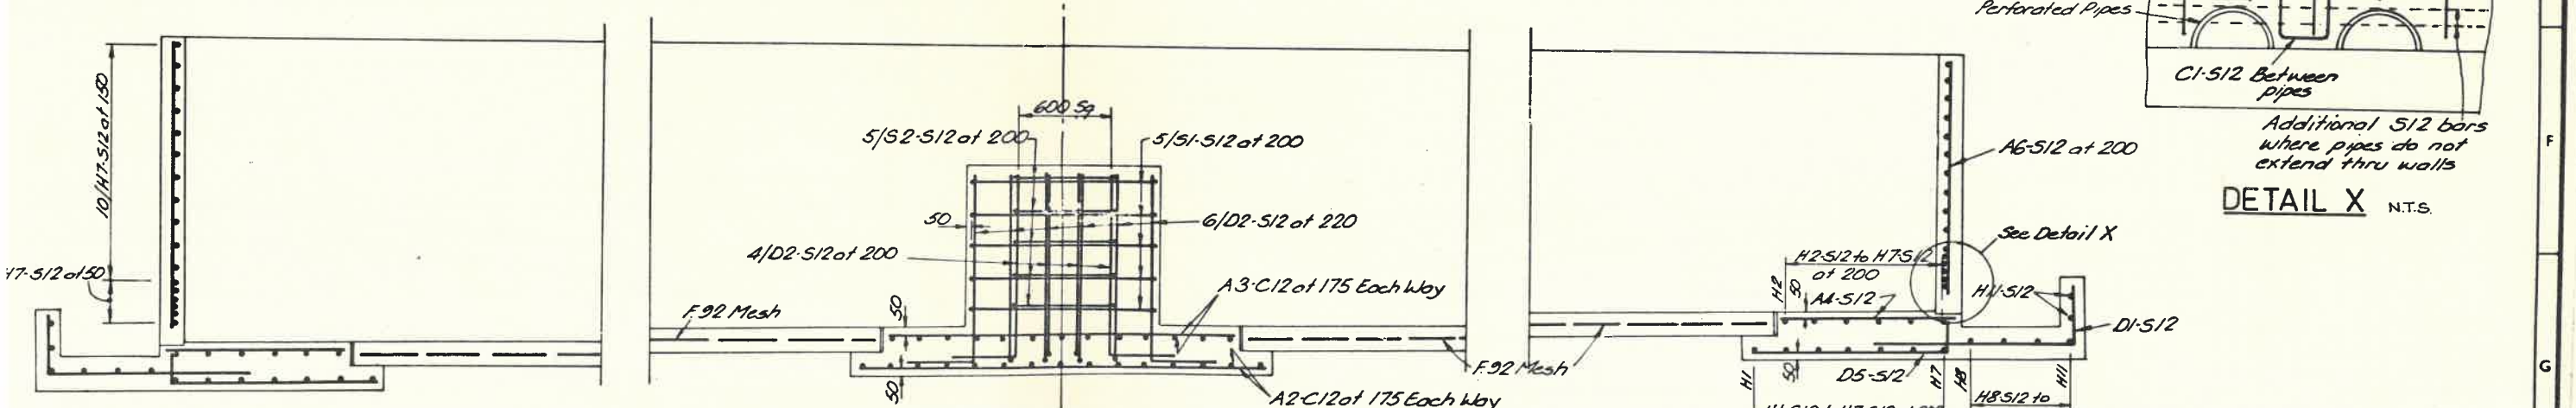

SECTION A-A SCALE B

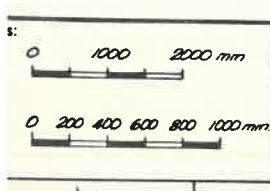

NOTES:-  
 1. Reinforcement to be centrally located unless shown otherwise  
 2. Reinforcement bars to be cut or displaced about pipes & openings to give 50 min. cover  
 3. Refer also "Standard Notes for Reading Detailed Reinforced Concrete Drawings"

No.	By	Date	Description
A	J.G.	20.3.84	Amended Reinforcement



Drawn	Date
J.G.	7/83
Checked	W.H.
Designed	P.S.
Checked	R.S.S.

**Cameron McNamara**  
 Cameron McNamara Pty Ltd  
 (Incorporated in Queensland)

BANANA SHIRE COUNCIL  
 BILOELA SEWERAGE TREATMENT WORKS  
 BIOLOGICAL TRICKLING FILTER  
 REINFORCEMENT

4-507  
 Job No. 83-2305  
 Drawing No. 69194

*Handwritten signature and initials*

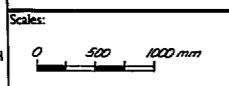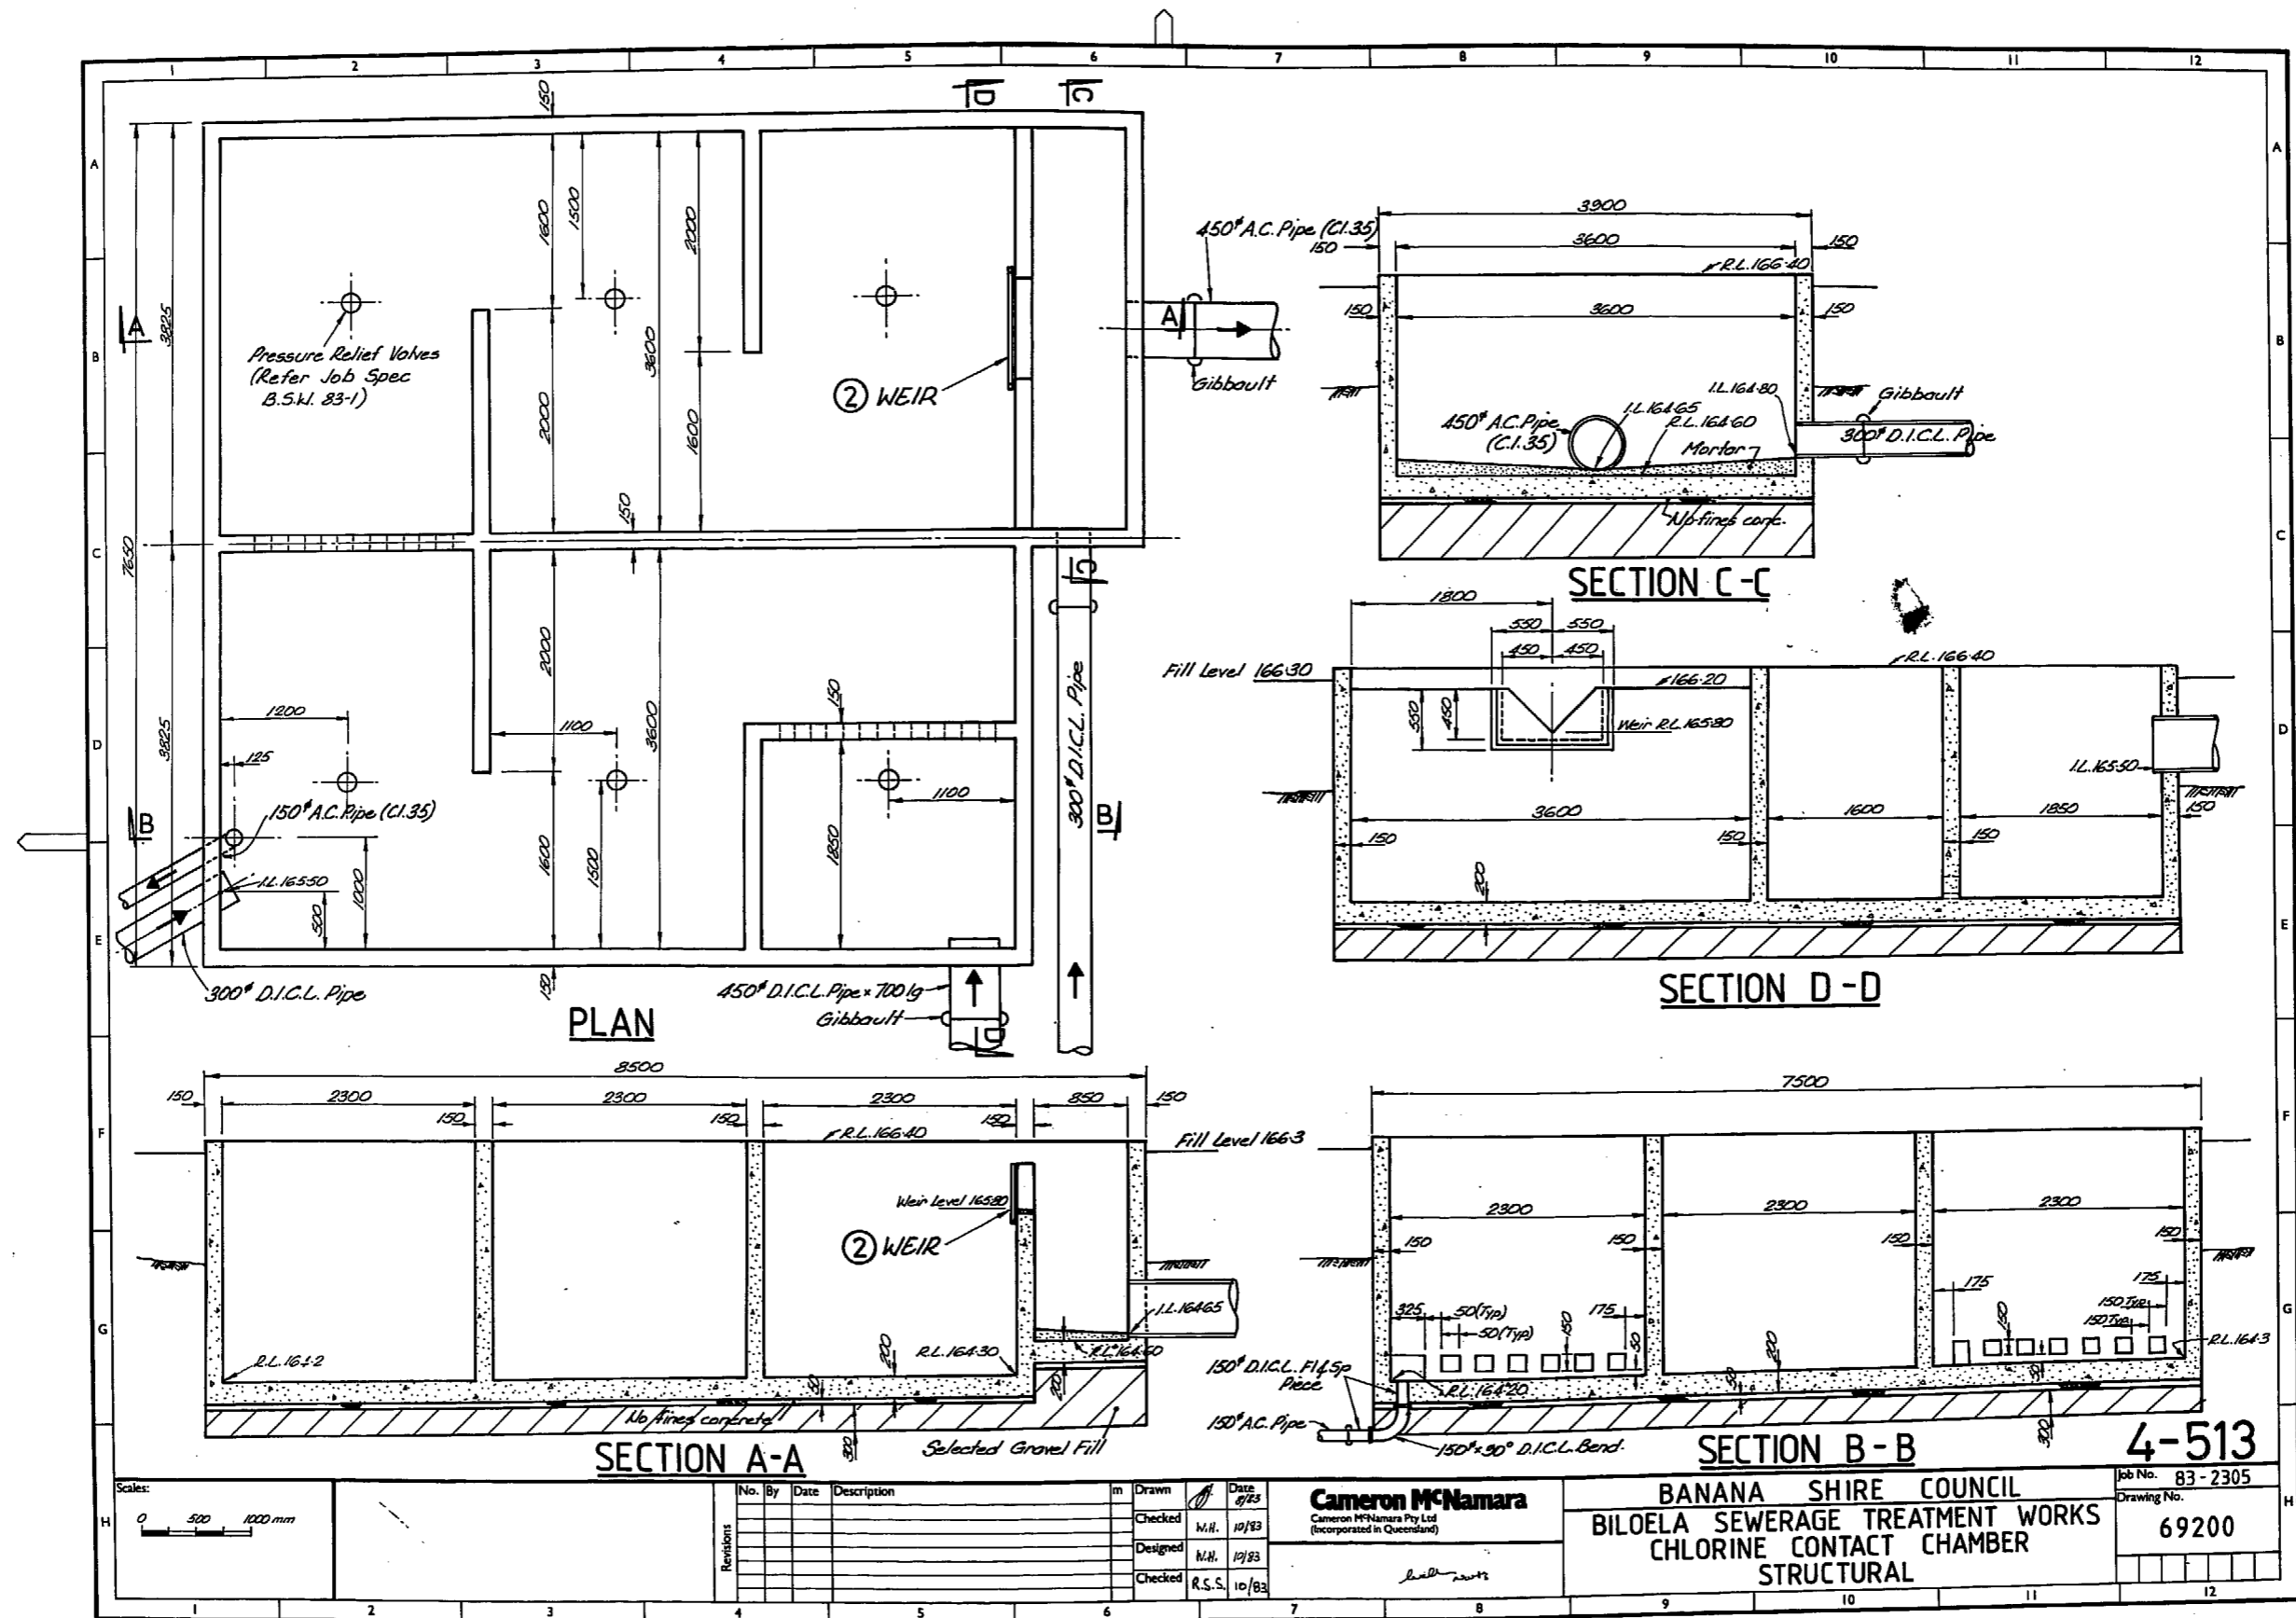

No.	By	Date	Description

Drawn	Date
Checked	10/83
Designed	10/83
Checked	10/83

**Cameron McNamara**  
 Cameron McNamara Pty Ltd  
 (Incorporated in Queensland)

**BANANA SHIRE COUNCIL**  
**BILOELA SEWERAGE TREATMENT WORKS**  
**CHLORINE CONTACT CHAMBER**  
**STRUCTURAL**

Job No. 83-2305

Drawing No. 69200

**4-513**

