



SECTION 1
1 : 25
STR-1025

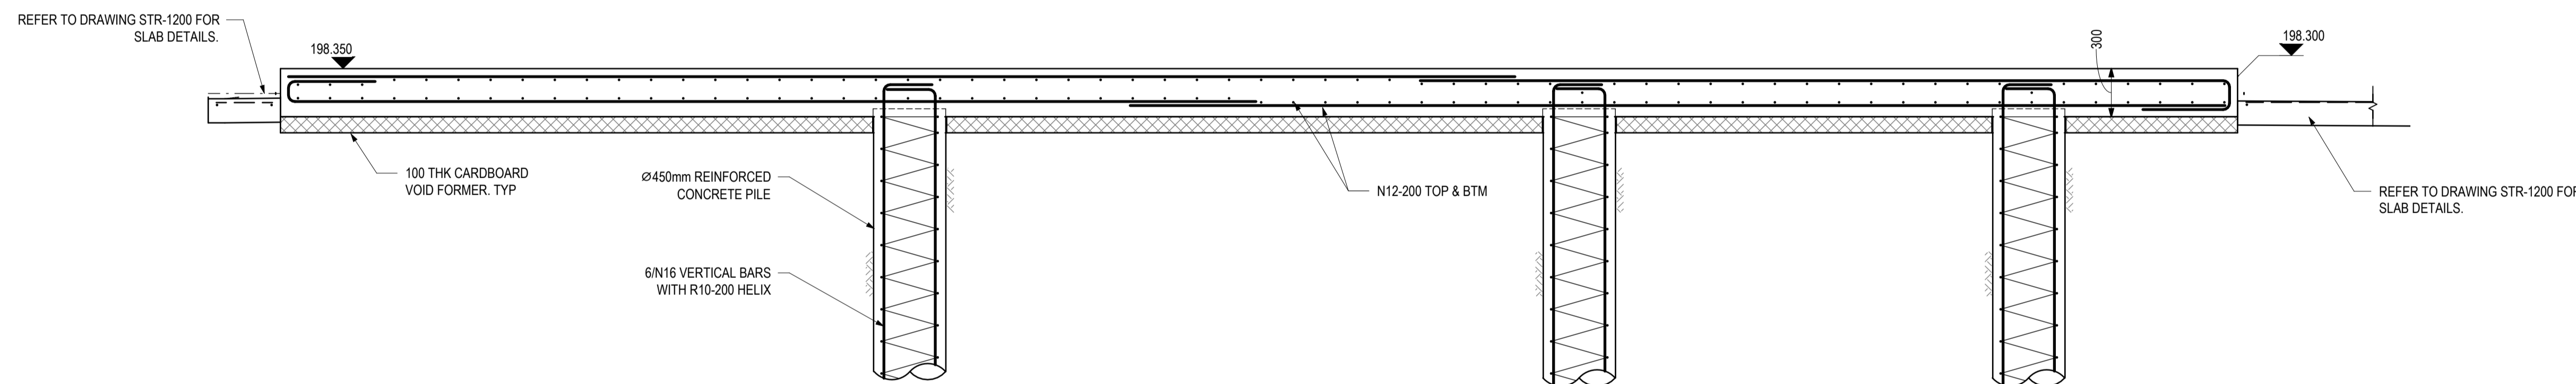

SECTION 2
1 : 25
STR-1025

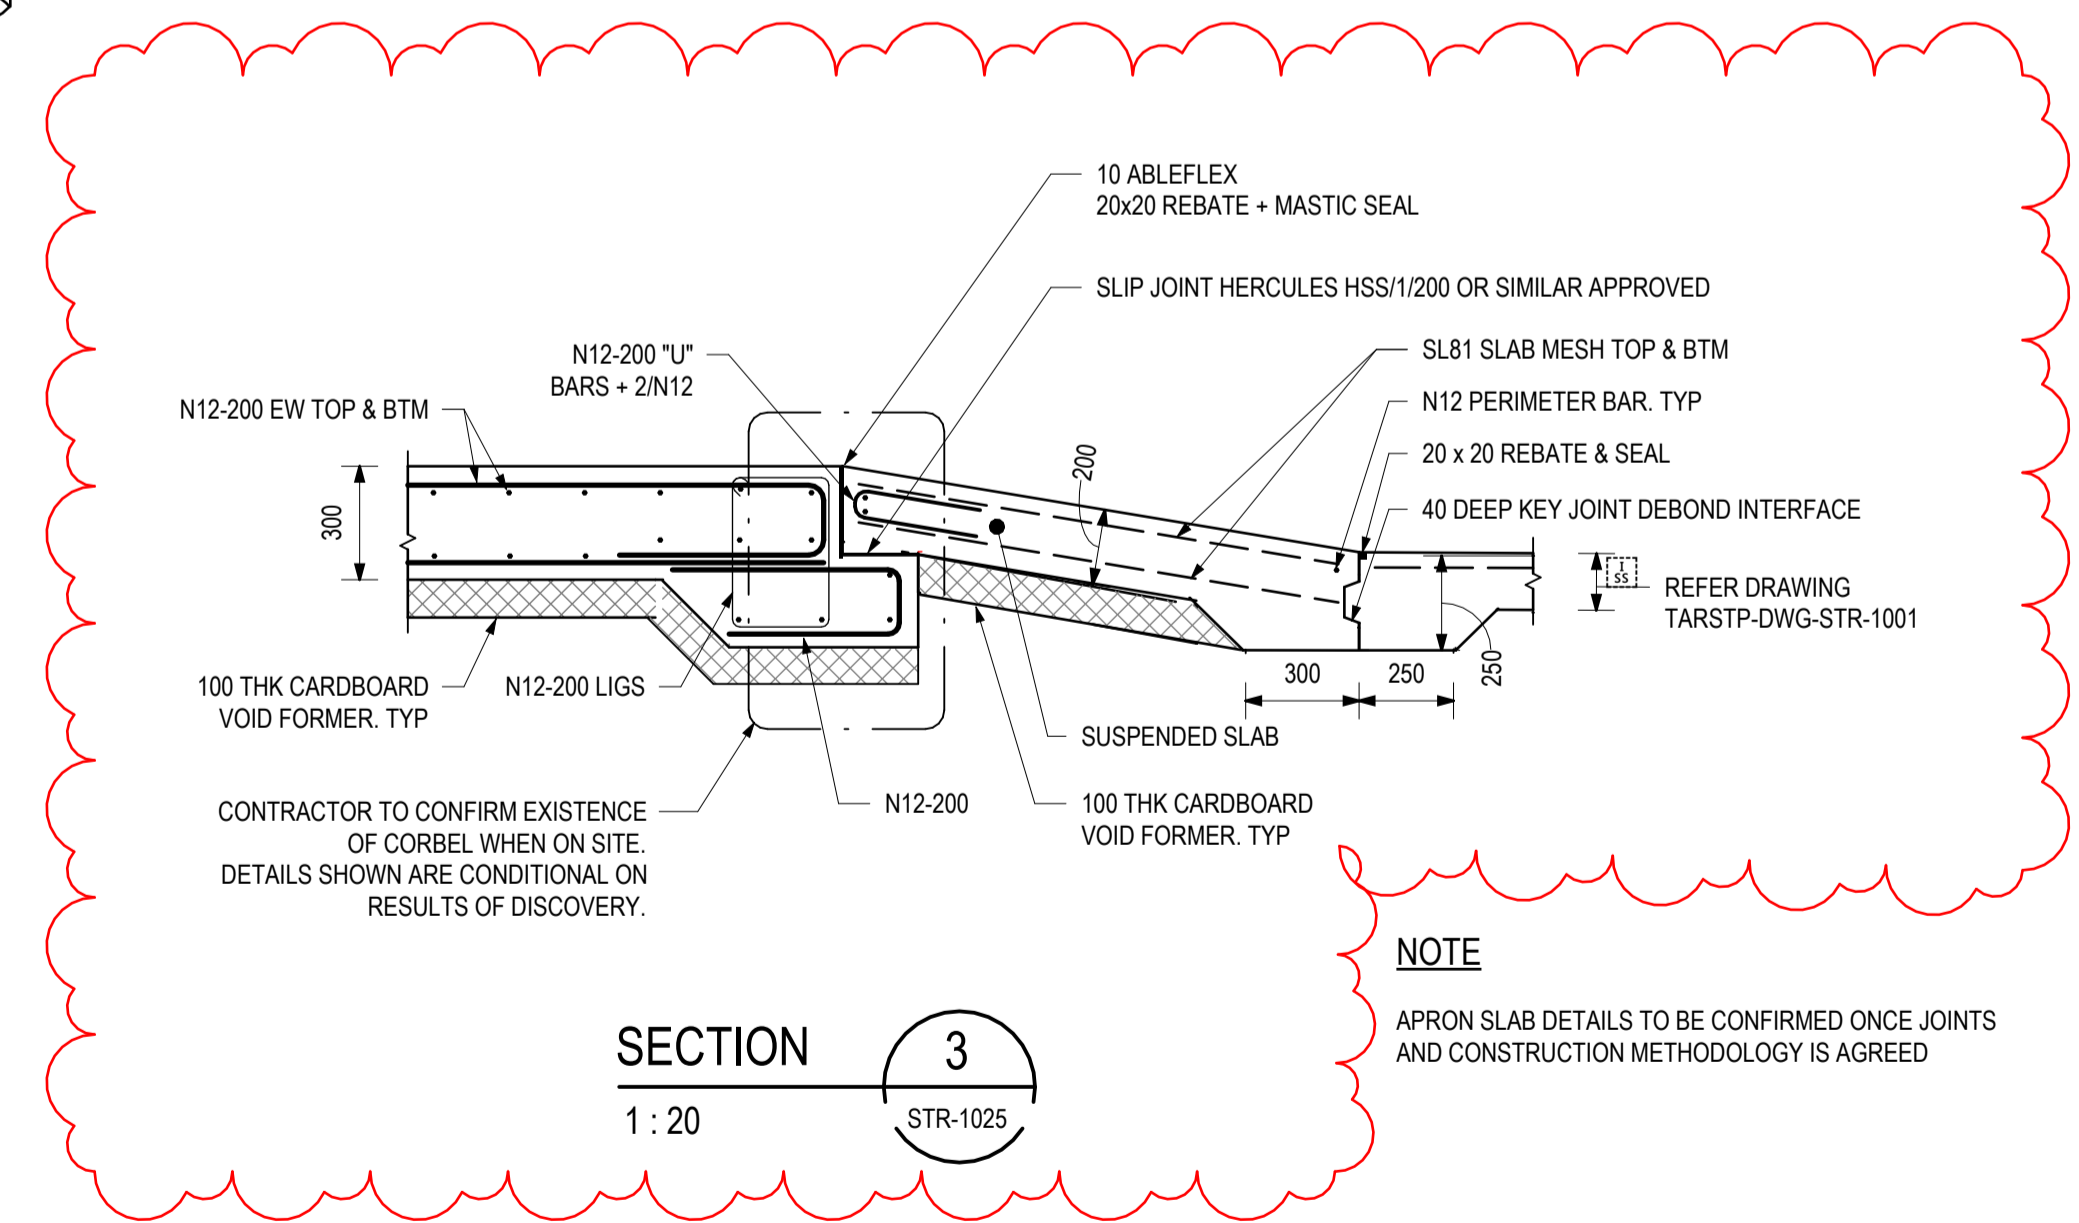

SECTION 3
1 : 20
STR-1025

NOTE
APRON SLAB DETAILS TO BE CONFIRMED ONCE JOINTS AND CONSTRUCTION METHODOLOGY IS AGREED

C:\Users\pau\OneDrive\Documents\GANDEN_Plan_L10\Documents\2023\2023_MDL_01_enr\pau20231.rvt

GANDEN
ENGINEERS AND PROJECT MANAGERS

HEAD OFFICE - GOLD COAST
SUITE 106, 30 LAKE ORR DRIVE,
VARSVITY LAKES, QLD 4227

T 07 5647 6052
E enquiries@ganden.com.au

SCALES

ORIG. SIZE **A1**

REV	DESCRIPTION	DATE	DWN	APP
2	RE-ISSUED FOR CONSTRUCTION	31.05.23	CP	PG
1	ISSUED FOR CONSTRUCTION	13.09.21	JM	PG
0	ISSUED FOR CONSTRUCTION	23.04.21	RDN	PG

AS CONSTRUCTED	REV
NAME:	
DATE:	
SIGNATURE:	
RPEQ No.	
FOR CONSTRUCTION	REV
NAME:	P. GILL
DATE:	14.09.21
SIGNATURE:	
RPEQ No.	3227

Client

DRAWING STATUS	CONSTRUCTION	
TITLE	TAROOM SEWAGE TREATMENT PLANT UPGRADE AEROBIC TANKS SLAB SECTIONS	
DRAWING NUMBER	TARSTP - DWG- STR-1028	REVISION
		2