


2
STR-1028

NOTE

APRON SLAB DETAILS TO BE CONFIRMED ONCE JOINTS AND CONSTRUCTION METHODOLOGY IS AGREED

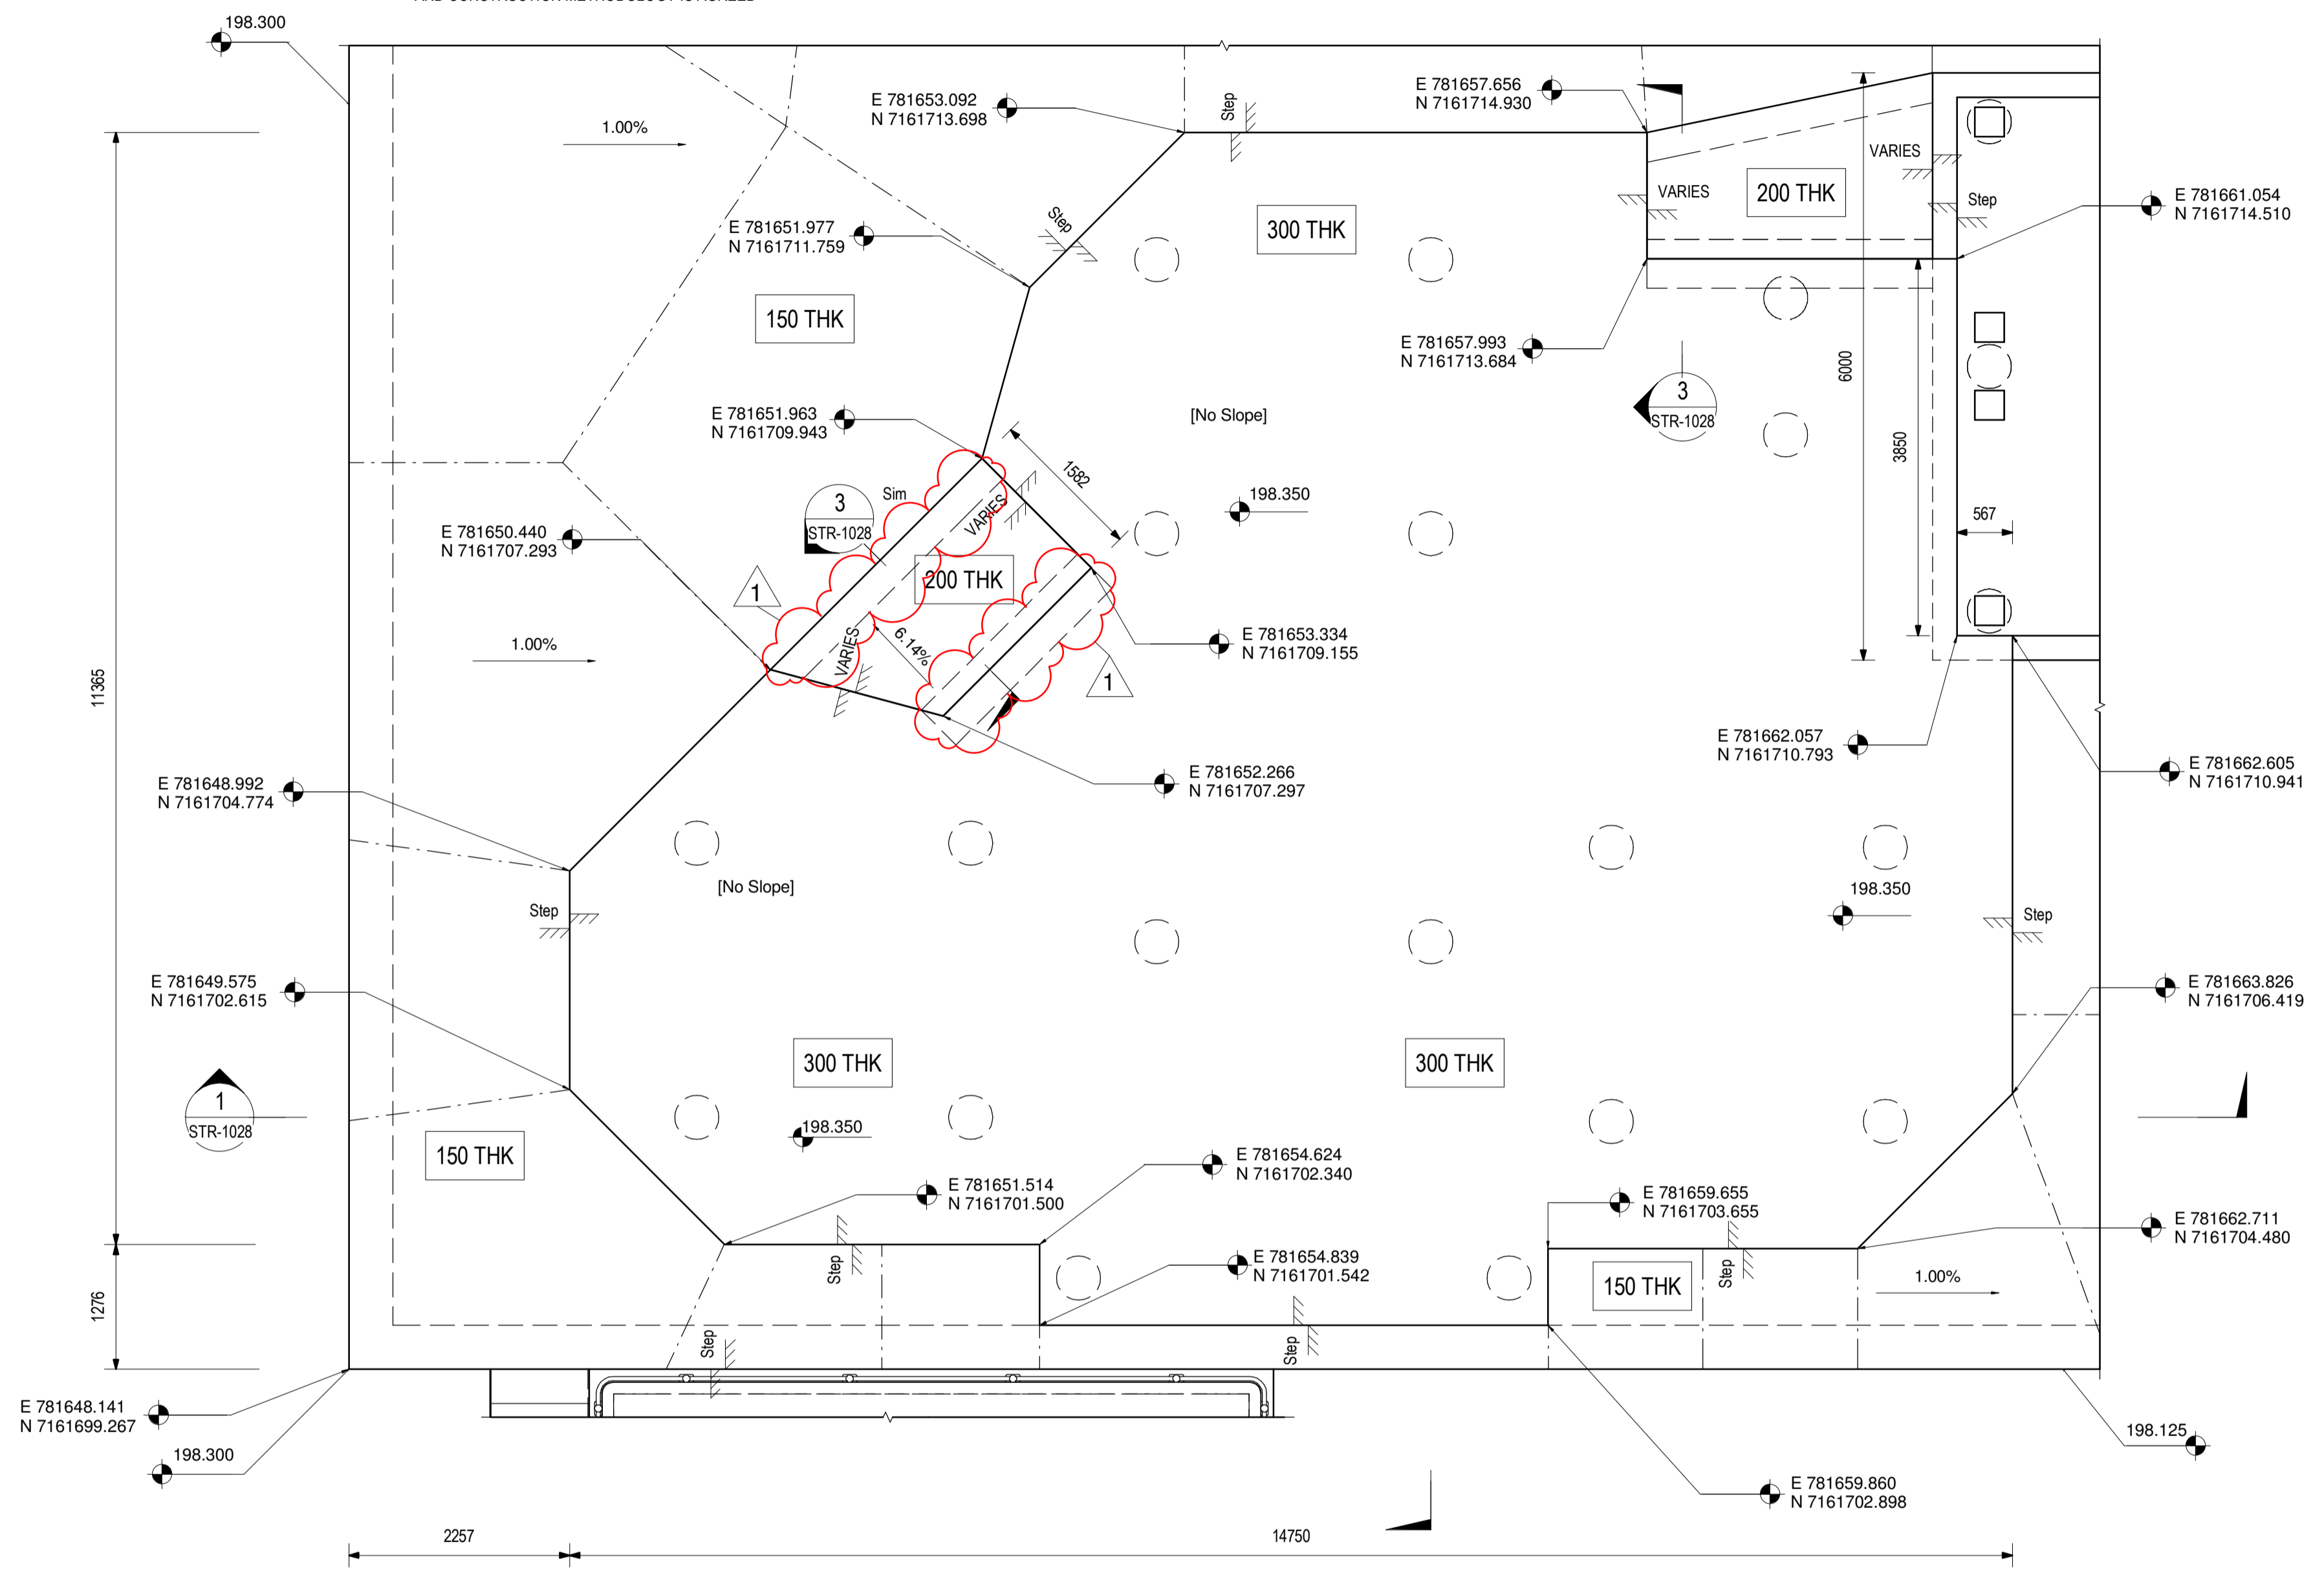

AEROBIC CONCRETE PLAN

SCALE: 1 : 50



HEAD OFFICE - GOLD COAST
SUITE 106, 20 LAKE ORR DRIVE,
VARSVITY LAKES, QLD 4227
T 07 5689 1457
E enquiries@ganden.com.au



SCALES 100mm ON ORIGINAL DRAWING

ORIG. SIZE A1

REV	DESCRIPTION	DATE	DWN	APP
1	ISSUED FOR CONSTRUCTION	13.09.21	JM	PG
0	ISSUED FOR CONSTRUCTION	23.04.21	RDN	PG

AS CONSTRUCTED	REV
NAME:	
DATE:	
SIGNATURE:	
RPEQ No.	
FOR CONSTRUCTION	REV 1
NAME:	P. GILL
DATE:	13.09.21
SIGNATURE:	<i>[Signature]</i>
RPEQ No.	3227



DRAWING STATUS	CONSTRUCTION	
TITLE	TAROOM SEWAGE TREATMENT PLANT UPGRADE AEROBIC TANKS & CLARIFIER AREA AEROBIC TANK SLAB PLAN	
DRAWING NUMBER	TARSTP -DWG- STR-1025	REVISION 1